

MISSISSIPPI DEPARTMENT OF NATURAL RESOURCES

Bureau of Land and Water Resources

Southport Mall

P.O. Box 10631

Jackson, Mississippi 39209 **CODED**

WATER WELL DRILLERS LOG

Sun Flower
R 113
5-13-81

May 13 1981
date well completed

Lanning Well's pump
firm name

Sunflower
county well located

LANDOWNER: <u>Evert Williams</u>	description of formations encountered	from	to
<u>Moorhead ms.</u> (mailing address)	<u>Clay</u>	<u>0</u>	<u>28</u>
	<u>Fine Sand</u>	<u>28</u>	<u>53</u>
	<u>Coarse Sand</u>	<u>53</u>	<u>120</u>
WELL LOCATION:			
sec. <u>13</u> T. <u>18</u> N R. <u>3</u> E <u>4</u> miles <u>SE</u> of <u>Moorhead</u>			
(distance) (direction) (nearest town)			
WELL PURPOSE: <u>test</u> (home, irrigation, municipal, industrial)			
WELL COMPLETION DATA:			
(1) diameter (inches) <u>12"</u>			
(2) total depth (feet) <u>120'</u>			
(3) static water level (feet) <u>25</u> below top of ground.			
(4) casing <u>Steel</u> , <u>80'</u> (material) (depth)			
(size) if telescope see back.			
(5) screen <u>40'</u> , <u>80'</u> (length) (depth to top)			
<u>12"</u> , <u>Steel</u> (size) (material)			
(6) pump <u>30</u> , <u>1500</u> (HP) (yield gpm)			
(type power)			
(7) electric log <u>no</u> (yes or no)			
(organization running log)			
(8) how well bottom plugged <u>Steel Plate</u>			
DRILLERS REMARKS:			

CODED


DEPT. OF NATURAL RESOURCES
BUREAU OF LAND & WATER RESOURCES

OCT 15 1981

RECEIVED

If well telescopes please sketch and show depths.

GROUND LEVEL

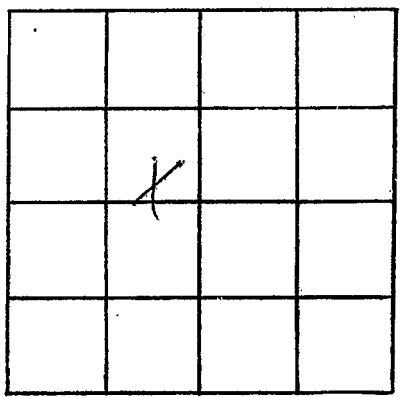

SECTION 13

Please indicate well location X.

ADDITIONAL INFORMATION

If more than one screen, show locations of each on sketch.