

MISSISSIPPI DEPARTMENT OF NATURAL RESOURCES

Bureau of Land and Water Resources

Southport Mall

P.O. Box 10631

Jackson, Mississippi 39209

CODED

WATER WELL DRILLERS LOG

SUNFLOWER
R 114
8-13-81

Aug. 13 1981
 date well completed

Leary's Well & Pump
 firm name

Sunflower
 county well located

LANDOWNER: Paul Smith

description of formations encountered

from

to

Moorhead, ms.
 (mailing address)

Clay
 Fine Sand
 Coarse Sand
 0 30
 30 63
 63 124

WELL LOCATION:

sec. 19 T. 18 N. R. 3 E.
 3 miles SW of Moorhead
 (distance) (direction) (nearest town)

WELL PURPOSE: Drinking Water
 (home, irrigation, municipal, industrial)

WELL COMPLETION DATA:

(1) diameter (inches) 16"
 (2) total depth (feet) 126'
 (3) static water level (feet) 24' below top of ground.

(4) casing steel, 86'
 (material) (depth)

(size) if telescope see back.

(5) screen 40', 86'
 (length) (depth to top)

16" Steel
 (size) (material)

(6) pump 60, 3000
 (HP) (yield gpm)

(type power)

(7) electric log No.
 (yes or no)

(organization running log)

(8) how well bottom plugged Steel Plate

DRILLERS REMARKS:

CODED


MISSISSIPPI DEPARTMENT OF NATURAL RESOURCES
 BUREAU OF LAND & WATER RESOURCES

OCT 19 1981

RECEIVED

If well telescopes please sketch and show depths.

GROUND LEVEL

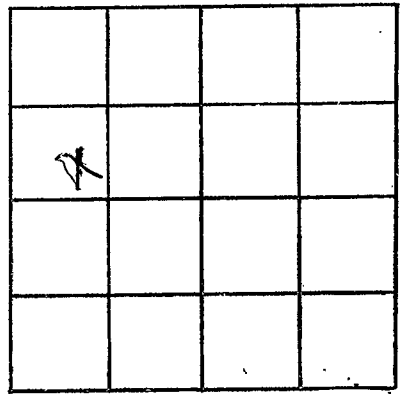

SECTION 19

Please indicate well location X.

ADDITIONAL INFORMATION

If more than one screen,
show locations of each on sketch.