

MISSISSIPPI DEPARTMENT OF NATURAL RESOURCES

Bureau of Land and Water Resources

Southport Mall

P.O. Box 10631

CODED

Jackson, Mississippi 39209

WATER WELL DRILLERS LOG

SUNFLOWER
R 11 11
9/11/81

Sept. 11 1981 date well completed
 Larry's Well's Pump firm name
 Sunflower county well located

LANDOWNER:	description of formations encountered	from	to
Wheeler Timber			
Monroeville, Mo. (mailing address)	CLAY	0	35
	FINE SAND	35	65
	COARSE SAND & GRAVEL	65	120
WELL LOCATION: sec. 20 T 18 N R 3 E W 4 (distance) miles (direction) of Monroeville (nearest town)			
WELL PURPOSE: <u>drinking</u> (home, irrigation, municipal, industrial)			
WELL COMPLETION DATA:			
(1) diameter (inches) 16"			
(2) total depth (feet) 120'			
(3) static water level (feet) 28' below top of ground.			
(4) casing STEEL 90' (material), (depth) 16" (size) if telescope see back.			
(5) screen 140" 80' (length), (depth to top) 16" (size), STEEL (material)			
(6) pump 2/0 2000 (HP) (yield gpm) D (type power)			
(7) electric log NO (yes or no) (organization running log)			
(8) how well bottom plugged steel plate			
DRILLERS REMARKS:			


DEPT. OF NATURAL RESOURCES
 BUREAU OF LAND & WATER RESOURCES

JAN 8 1982

RECEIVED

If well telescopes please sketch and show depths.

GROUND LEVEL

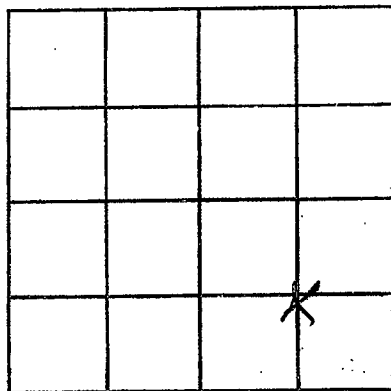

SECTION 20

Please indicate well location X.

ADDITIONAL INFORMATION

If more than one screen,
show locations of each on sketch.