

MISSISSIPPI DEPARTMENT OF NATURAL RESOURCES

Bureau of Land and Water Resources

Southport Mall

P.O. Box 10631

Jackson, Mississippi 39209

WATER WELL DRILLERS LOG

CODED

Imperial
TR 118
09/26/81

Sept 26 1981 Larry's well's pump Imperial
 date well completed firm name county well located

LANDOWNER: <u>Wheeler Timbs</u>	description of formations encountered	from	to
<u> Moorhead ms.</u> (mailing address)	<u>CLAY</u>	<u>0</u>	<u>100</u>
WELL LOCATION: sec. <u>20</u> T. <u>18</u> N. R. <u>3</u> E <u>4</u> miles <u>S</u> of <u>Mercedal</u> (distance) (direction) (nearest town)	<u>FINED SAND</u>	<u>40</u>	<u>60</u>
WELL PURPOSE: <u>test hole</u> (home, irrigation, municipal, industrial)	<u>CORSEGA</u>	<u>60</u>	<u>100</u>
WELL COMPLETION DATA:			
(1) diameter (inches) <u>8"</u>			
(2) total depth (feet) <u>100'</u>			
(3) static water level (feet) <u>26</u> below above top of ground.			
(4) casing <u>PVC</u> <u>60'</u> (material) (depth)			
_____ if telescope see back. (size)			
(5) screen <u>40</u> <u>60</u> (length) (depth to top)			
(6) pump <u>8"</u> <u>PVC</u> (size) (material)			
(7) pump <u>10</u> <u>700</u> (HP) (yield gpm)			
<u>ELECT</u> (type power)			
(7) electric log <u>NO</u> (yes or no)			
_____ (organization running log)			
(8) how well bottom plugged <u>PVC</u> <u>cap</u>			
DRILLERS REMARKS:			


DEPT. OF NATURAL RESOURCES
 BUREAU OF LAND & WATER RESOURCES

JAN 27 1982

RECEIVED

If well telescopes please sketch and show depths.

GROUND LEVEL

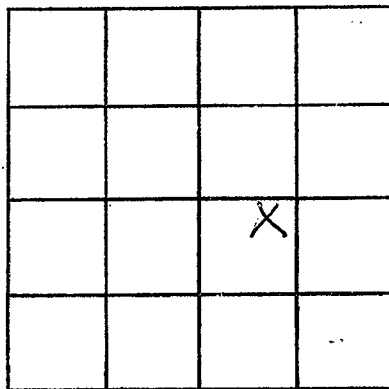

SECTION 20

Please indicate well location X.

ADDITIONAL INFORMATION

If more than one screen,
show locations of each on sketch.