

MISSISSIPPI DEPARTMENT OF NATURAL RESOURCES

Bureau of Land and Water Resources

Southport Mall

P.O. Box 10631

Jackson, Mississippi 39209

CODED

WATER WELL DRILLERS LOG

Amflower
R 119
6/23/82

6-23
date well completed

19 82 Larry's Well & Pumps
firm name

Amflower
county well located

LANDOWNER: <i>Wood's Farm</i>	description of formations encountered	from	to
<i>moorhead</i>			
<i>moorhead</i> (mailing address)	<i>clay</i> <i>f. sand</i> <i>course sandstg.</i>	0 25 56	25 50 100
WELL LOCATION:			
sec. <u>13</u> T <u>18</u> N R <u>3</u> E S W			
3 East miles 1 South, moorhead (distance) (direction) (nearest town)			
WELL PURPOSE: <i>fish pond</i> (home, irrigation, municipal, industrial)			
WELL COMPLETION DATA:			
(1) diameter (inches) <u>8"</u>			
(2) total depth (feet) <u>100'</u>			
(3) static water level (feet) <u>26'</u> below top of ground. above			
(4) casing <u>plastic</u> , <u>60'</u> (material) (depth) (size) if telescope see back.			
(5) screen <u>40'</u> , <u>60'</u> (length) (depth to top)			
<u>8"</u> , <u>plastic</u> (size) (material)			
(6) pump <u>7 1/2</u> , <u>500</u> (HP) (yield gpm)			
(type power)			
(7) electric log <u>No</u> (yes or no)			
(organization running log)			
(8) how well bottom plugged <u>Pdc</u> <u>cap</u>			
DRILLERS REMARKS:			


DEPT. OF NATURAL RESOURCES
BUREAU OF LAND & WATER RESOURCES

SEP 15 1982

RECEIVED

If well telescopes please sketch and show depths.

GROUND LEVEL

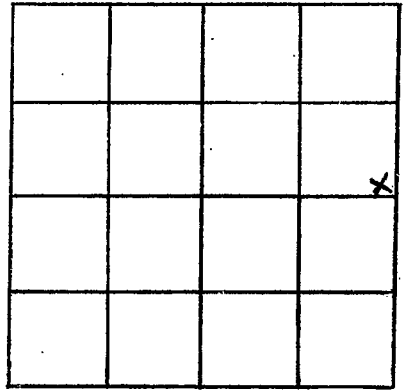

SECTION 13

Please indicate well location X.

ADDITIONAL INFORMATION

If more than one screen,
show location's of each on sketch.