

MISSISSIPPI DEPARTMENT OF NATURAL RESOURCES

Bureau of Land and Water Resources

Southport Mall

P.O. Box 10631

Jackson, Mississippi 39209

CODED

WATER WELL DRILLERS LOG

Sumflow
R 127
6/24/82

6-24 19 82 Jerry's Well & Pump Co. Sumflow
 date well completed firm name county well located


LANDOWNER: <u>Woods Farm</u>	description of formations encountered	from	to
(mailing address)			
<u>morehead</u>	<u>slay</u>	<u>8</u>	<u>25</u>
	<u>metes</u>	<u>25</u>	<u>50</u>
	<u>course S and 1/4</u>	<u>50</u>	<u>174</u>
WELL LOCATION:			
sec. <u>13</u> T <u>18</u> N R <u>3</u> E S W			
<u>3 E</u> miles <u>1 S</u> of <u>morehead</u>			
(distance) (direction) (nearest town)			
WELL PURPOSE: <u>Fish Pond</u> (home, irrigation, municipal, industrial)			
WELL COMPLETION DATA:			
(1) diameter (inches) <u>16"</u>			
(2) total depth (feet) <u>114'</u>			
(3) static water level (feet) <u>26'</u> below above top of ground.			
(4) casing <u>steel</u> , <u>74'</u> (material) (depth)			
(size) If telescope see back.			
(5) screen <u>40</u> , <u>74"</u> (length) (depth to top)			
<u>16"</u> , <u>steel</u> (size) (material)			
(6) pump <u>60</u> , <u>3600</u> (HP) (yield gpm)			
<u>Electric</u> (type power)			
(7) electric log (yes or no)			
(organization running log)			
(8) how well bottom plugged			
DRILLERS REMARKS:			

DEPT. OF NATURAL RESOURCES
 BUREAU OF LAND & WATER RESOURCES

SEP 15 1982
 RECEIVED

If well telescopes please sketch and show depths.

GROUND LEVEL

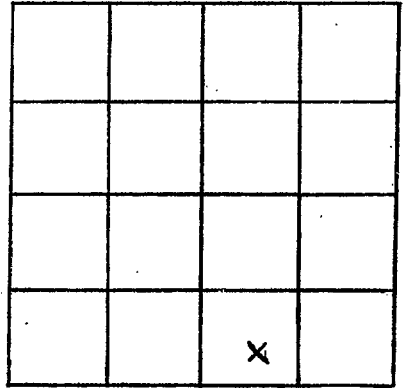

SECTION 13

Please indicate well location X.

ADDITIONAL INFORMATION

If more than one screen,
show locations of each on sketch.