

SUNFLOWER
 R 126
 04-18-79

MISSISSIPPI
 BOARD OF WATER COMMISSIONERS
 416 North State Street
 Jackson, Mississippi 39201

CODED

WATER WELL DRILLERS LOG
 BUTANE GAS COMPANY

4-18-79 19 date well completed
 MOORHEAD OF GREENWOOD Sunflower county well located

LANDOWNER:
 Roberts Bros.
 Moorhead
 (mailing address)

description of formations encountered	from	to
Sandy Clay	0	10
Fine Sand	10	20
COARSE SAND	20	35
SAND + Pea Gravel	35	60
GRAVEL	60	100

WELL LOCATION:
 sec. 16 T 18 N R 3 E
 S W
 1 miles SW of Moorhead
 (distance) (direction) (nearest town)

WELL PURPOSE: FRR
 (home, irrigation, municipal, industrial)

WELL COMPLETION DATA:

(1) diameter (inches) 16"

(2) total depth (feet) 100

(3) static water level (feet) 20 below above top of ground.

(4) casing Steel 60 (material) (depth)
 16" (size) If telescope see back.

(5) screen 40 60 (length) (depth to top)
 16" Steel (size) (material)

(6) pump 60 2800 (HP) (yield gpm)
 Diesel (type power)

(7) electric log No (yes or no)
 (organization running log)

(8) how well bottom plugged Steel Plate

DRILLERS REMARKS:


MISS. BOARD OF WATER COMMISSIONERS

MAY - 9 1979

RECEIVED

If well telescopes please sketch and show depths.

GROUND LEVEL

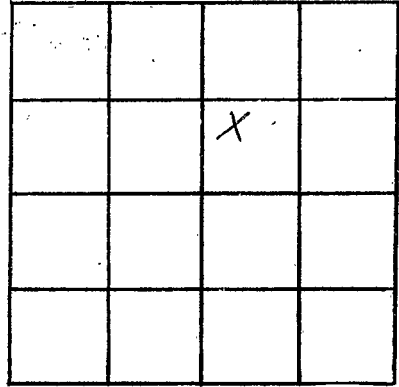

SECTION 16

Please indicate well location X.

ADDITIONAL INFORMATION

If more than one screen,
show locations of each on sketch.