

MISSISSIPPI DEPARTMENT OF NATURAL RESOURCES

Bureau of Land and Water Resources

Southport Mall

P.O. Box 10631

Jackson, Mississippi 39209

WATER WELL DRILLERS LOG

Sunflower  
R 128  
4/26/83

April 26 1983 Larry's well & pump Sunflower  
 date well completed firm name county well located

LANDOWNER: <u>Harris Russell</u>	description of formations encountered	from	to
<u>Moorehead, ms</u> (mailing address)	<u>clay</u> <u>Sand</u> <u>Sand &amp; gravel</u>	<u>0</u> <u>30</u> <u>80</u>	<u>30</u> <u>50</u> <u>100</u>
<b>WELL LOCATION:</b> sec. <u>15</u> T. <u>18</u> N R. <u>3</u> E S <u>3</u> W <u>1</u> miles <u>South</u> of <u>Moorehead</u> (distance) (direction) (nearest town)			
<b>WELL PURPOSE:</b> <u>Fish</u> (home, irrigation, municipal, industrial)			
<b>WELL COMPLETION DATA:</b>			
(1) diameter (inches) <u>8"</u>			
(2) total depth (feet) <u>100'</u>			
(3) static water level (feet) <u>26'</u> <sup>below</sup> / <sub>above</sub> top of ground.			
(4) casing <u>PVC</u> , <u>60'</u> (material) (depth) (size) if telescope see back.			
(5) screen <u>40'</u> , <u>60'</u> (length) (depth to top) <u>8"</u> , <u>PVC</u> (size) (material)			
(6) pump <u>10</u> , <u>700</u> (HP) (yield gpm) <u>Electric</u> (type power)			
(7) electric log <u>No</u> (yes or no) (organization running log)			
(8) how well bottom plugged <u>PVC</u> <u>cap</u>			
DRILLERS REMARKS:			

CODL


DEPT. OF NATURAL RESOURCES  
 BUREAU OF LAND & WATER RESOURCES

JUN - 8 1983

RECEIVED

If well telescopes please sketch and show depths.

GROUND LEVEL

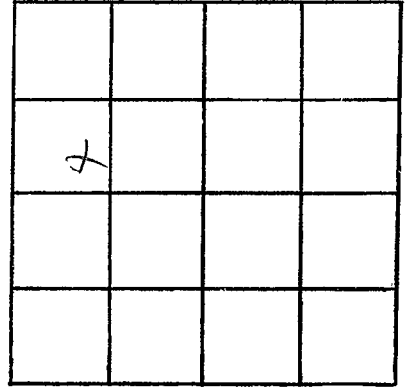

SECTION 15

Please indicate well location X.

ADDITIONAL INFORMATION

If more than one screen,  
show locations of each on sketch.