

MISSISSIPPI DEPARTMENT OF NATURAL RESOURCES

Bureau of Land and Water Resources

Southport Mall

P.O. Box 10631

Jackson, Mississippi 39209

WATER WELL DRILLERS LOG

Sunflower
R 129
4/25/83

date well completed April 25 1983 firm name Larry's Well & Pump county well located Sunflower

LANDOWNER: <u>Harris Russell</u>	description of formations encountered	from	to
<u>Moorehead Mo.</u> (mailing address)	<u>clay</u>	<u>0</u>	<u>30</u>
WELL LOCATION:	<u>Sand</u>	<u>30</u>	<u>60</u>
sec. <u>55</u> T <u>18</u> (N) R <u>3</u> (E) S <u>3</u> (W) <u>2</u> miles <u>South</u> of <u>Moorehead</u> (distance) (direction) (nearest town)	<u>Sand & gravel</u>	<u>60</u>	<u>140</u>
WELL PURPOSE: <u>Res</u> (home, irrigation, municipal, industrial)	<u>clay</u>	<u>140</u>	<u>220</u>
WELL COMPLETION DATA:	<u>clay & sand</u>	<u>220</u>	<u>500</u>
(1) diameter (inches) <u>4" x 2"</u>	<u>clay</u>	<u>500</u>	<u>630</u>
(2) total depth (feet) <u>1500</u>	<u>Sand</u>	<u>630</u>	<u>670</u>
(3) static water level (feet) <u>20'</u> <u>below</u> <u>above</u> top of ground.	<u>clay & sand</u>	<u>670</u>	<u>1400</u>
(4) casing <u>Plastic</u> , <u>1440</u> (material) (depth)	<u>Sand</u>	<u>1400</u>	<u>1500</u>
_____ (size) if telescope see back.	CODED		
(5) screen <u>60'</u> , <u>1440'</u> (length) (depth to top)			
_____ (size), _____ (material)			
(6) pump <u>603</u> , <u>60</u> (HP) (yield gpm)			
_____ (type power)			
(7) electric log _____ <u>NO</u> (yes or no)			
_____ (organization running log)			
(8) how well bottom plugged <u>Back wash valve</u>			
DRILLERS REMARKS:			


DEPT. OF NATURAL RESOURCES
 BUREAU OF LAND & WATER RESOURCES

JUN - 8 1983

RECEIVED

If well telescopes please sketch and show depths.

GROUND LEVEL

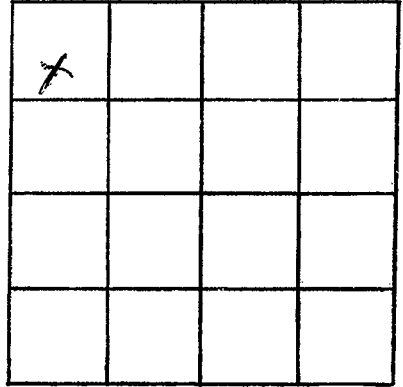

SECTION 22

Please indicate well location X.

ADDITIONAL INFORMATION

If more than one screen,
show locations of each on sketch.