

MISSISSIPPI DEPARTMENT OF NATURAL RESOURCES

Bureau of Land and Water Resources

Southport Mall

P.O. Box 10631

Jackson, Mississippi 39209

WATER WELL DRILLERS LOG

CODED

SUNFLOWER
R 131
8-31-83

Aug 31 1983 Larry's wells pump Sunflower Co
 date well completed firm name county well located

LANDOWNER: <u>Harris Russell</u>	description of formations encountered	from	to
<u>Marhead, Mo.</u> (mailing address)			
WELL LOCATION: sec. <u>15</u> T. <u>18</u> N. R. <u>3</u> E. S. W.	<u>Sand</u>	<u>30</u>	<u>50</u>
<u>1</u> miles <u>South</u> of <u>Marhead</u> (distance) (direction) (nearest town)	<u>concrete Sand</u>	<u>50</u>	<u>116</u>
WELL PURPOSE: <u>Fish Pond</u> (home, irrigation, municipal, industrial)			
WELL COMPLETION DATA:			
(1) diameter (inches) <u>12"</u>			
(2) total depth (feet) <u>116'</u>			
(3) static water level (feet) <u>29</u> <u>below</u> top of ground.			
(4) casing <u>Steel</u> , <u>76'</u> , (material) (depth)			
(size) if telescope see back.			
(5) screen <u>40'</u> , <u>76'</u> (length) (depth to top)			
<u>12"</u> , <u>Steel</u> (size) (material)			
(6) pump <u>40</u> <u>2000</u> (HP) (yield gpm)			
<u>0</u> (type power)			
(7) electric log <u>no</u> (yes or no)			
(organization running log)			
(8) how well bottom plugged <u>Steel Plate</u>			
DRILLERS REMARKS:			

CODED


DEPT. OF NATURAL RESOURCES
 BUREAU OF LAND & WATER RESOURCES

FEB 15 1984

RECEIVED

If well telescopes please sketch and show depths.

GROUND LEVEL

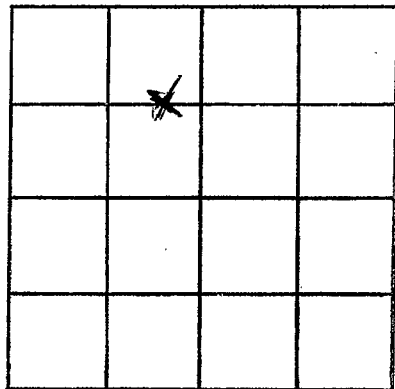

SECTION 15

Please indicate well location X.

ADDITIONAL INFORMATION

If more than one screen,
show locations of each on sketch.