

**MISSISSIPPI DEPARTMENT OF NATURAL RESOURCES**  
**Bureau of Land and Water Resources**  
 Southport Mall  
 P.O. Box 10631  
 Jackson, Mississippi 39209  
**WATER WELL DRILLERS LOG**

**CODED**

R132  
 Sunflower  
 10-21-83

Oct 21 1983 Lamm's well & pump Sunflower  
 date well completed firm name county well located

LANDOWNER: Jerry Nobile

description of formations encountered	from	to
clay	0	30
stone	30	50
sand & gravel	50	100

Moorhead, Ms  
 (mailing address)

WELL LOCATION:  
 sec. 6 T. 18 N R. 3 E  
 S W  
 2 mi miles E of Moorhead  
 (distance) (direction) (nearest town)

WELL PURPOSE:  
 (home, irrigation, municipal, industrial)

- WELL COMPLETION DATA:
- (1) diameter (inches) 12"
  - (2) total depth (feet) 100'
  - (3) static water level (feet) 29' below above top of ground.
  - (4) casing Steel, 60'  
 (material) (depth)  
 (size) if telescope see back.
  - (5) screen 40', 60'  
 (length) (depth to top)  
12", Steel  
 (size) (material)
  - (6) pump 25, 1200  
 (HP) (yield gpm)  
 (type power)
  - (7) electric log NO  
 (yes or no)

(organization running log)

(8) how well bottom plugged Steel plate

DRILLERS REMARKS:


DEPT. OF NATURAL RESOURCES  
 BUREAU OF LAND & WATER RESOURCES

APR - 2 1984

**RECEIVED**

If well telescopes please  
sketch and show depths.

GROUND LEVEL

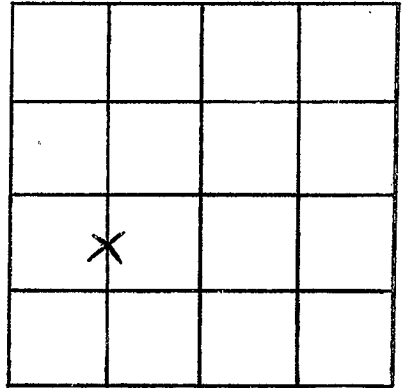

SECTION 5

Please indicate well location X.

ADDITIONAL INFORMATION

If more than one screen,  
show locations of each on sketch.