

MISSISSIPPI DEPARTMENT OF NATURAL RESOURCES

Bureau of Land and Water Resources

Southport Mall

P.O. Box 10631

Jackson, Mississippi 39209

WATER WELL DRILLERS LOG

CODED

R133
Sunflower
10-20-83

Oct 20 1983 Jerry's well pump Sunflower
date well completed firm name county/well located

LANDOWNER:

Jerry Nobels

description of formations encountered

from

to

Moorehead ms.
(mailing address)

clay	0	30
sand	30	50
sand & gravel	50	101

WELL LOCATION:

sec. 6 T. 18 N. R. E
S W
2 mi miles East of Moorehead
(distance) (direction) (nearest town)

WELL PURPOSE:

(home, irrigation, municipal, industrial)

WELL COMPLETION DATA:

- (1) diameter (inches) 12"
- (2) total depth (feet) 101'
- (3) static water level (feet) 29' below top of ground.
- (4) casing steel, 61' (material) (depth)
(size) if telescope see back.
- (5) screen 40' 61' (length) (depth to top)
12" steel (size) (material)
- (6) pump 80 1200 (HP) (yield gpm)
(type power)
- (7) electric log No (yes or no)
(organization running log)
- (8) how well bottom plugged Steel Plate

MISSISSIPPI DEPARTMENT OF NATURAL RESOURCES
BUREAU OF LAND & WATER RESOURCES


APR 29 1984

RECEIVED

DRILLERS REMARKS:

If well telescopes please sketch and show depths.

GROUND LEVEL

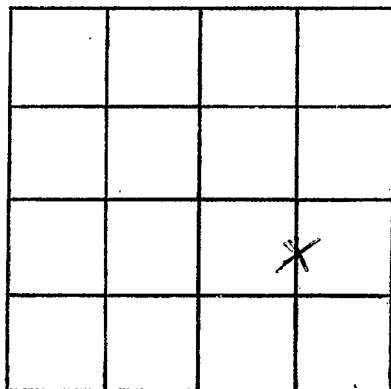

SECTION 6

Please indicate well location X.

ADDITIONAL INFORMATION

If more than one screen,
show locations of each on sketch.