

MISSISSIPPI DEPARTMENT OF NATURAL RESOURCES

Bureau of Land and Water Resources

Southport Mall

P.O. Box 10631

Jackson, Mississippi 39209

WATER WELL DRILLERS LOG

CODED

SUNFLOWER
R134

6-15 1984 Irrigation Equipment Sunflower
date well completed firm name county well located

LANDOWNER: Kenneth Walcott
Old Hwy. 61
Hollandale, Ms. 38748

description of formations encountered	from	to
CLAY	0	30
Fine sand/clay	31	40
Fine sand	41	73
COARSE SAND	74	113

(mailing address)

WELL LOCATION:

sec. 6 T. 18 (N) R. 3 E. (W)
4 miles W of INVERNESS
(distance) (direction) (nearest town)

WELL PURPOSE:

(home, irrigation, municipal, industrial)

WELL COMPLETION DATA:

- (1) diameter (inches) 12"
- (2) total depth (feet) 113
- (3) static water level (feet) 22 1/2 below top of ground.
- (4) casing Steel, 73' (material) (depth)
- (5) screen 40' 73' (length) (depth to top)
- (6) pump 12" 30 (size) (material) (HP) (yield gpm)
- Diesel Power unit (type power)
- (7) electric log (yes or no)

(organization running log)

- (8) how well bottom plugged Steel Plate


DRILLERS REMARKS:

CODED

MISSISSIPPI DEPARTMENT OF NATURAL RESOURCES
BUREAU OF LAND AND WATER RESOURCES
SEP - 4 1984
RECEIVED

If well telescopes please sketch and show depths.

GROUND LEVEL

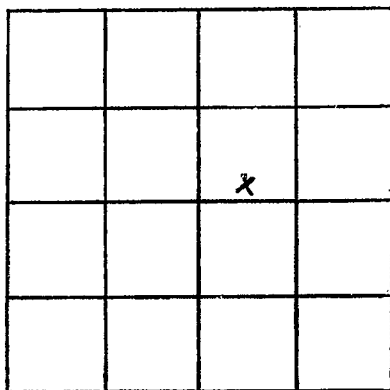

SECTION 6

Please indicate well location X.

ADDITIONAL INFORMATION

If more than one screen,
show locations of each on sketch.