

MISSISSIPPI DEPARTMENT OF NATURAL RESOURCES
Bureau of Land and Water Resources
 Southport Mall
 P.O. Box 10631
 Jackson, Mississippi 39209 **CODED**
WATER WELL DRILLERS LOG

R 137
SUNFLOWER
1-31-84

Jan 31 1984 Larry's well & pump Sunflower
 date well completed m name county well located

LANDOWNER: Bobby Duncan
Inverness Mo
 (mailing address)

WELL LOCATION:
 sec. 31 T. 18 N. R. 3 E. S. 5
4 miles NW of Inverness
 (distance) (direction) (nearest town)

WELL PURPOSE:
 (home, irrigation, municipal, industrial)

WELL COMPLETION DATA: 140 ± 4"
 (1) diameter (inches) 4" X 2"
 (2) total depth (feet) 720
 (3) static water level (feet) 30 below above top of ground.
 (4) casing PVC, 680
 (material) (depth)
4x2 if telescope see back.
 (size)
 (5) screen 40', 720-680
 (length) (depth to top)
2", 0010 PVC
 (size) (material)
 (6) pump 1, 20
 (HP) (yield gpm)
E-220
 (type power)
 (7) electric log NO
 (yes or no)


(organization running log)
 (8) how well bottom plugged Sand Shovel
1-18-85
J.P.

description of formations encountered	from	to
Clay	0	40
Rock & Gravel	40	50
Clay	50	60
Sand & Gravel	60	180
Clay	180	195
Sand	195	240
Clay	240	255
Sand	255	265
Clay	265	270
Sand	270	320
Clay	320	335
Sand	335	415
Clay	415	425
Sand	425	460
Clay	460	470
Sand	470	520
Clay	520	560
Sand	560	570
Clay	570	610
Sand	610	720

DRILLERS REMARKS:

If well telescopes please
sketch and show depths.

GROUND LEVEL

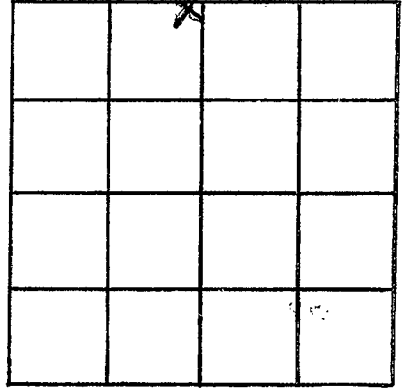

SECTION 31

Please indicate well location X.

ADDITIONAL INFORMATION

If more than one screen,
show locations of each on sketch.