

MISSISSIPPI DEPARTMENT OF NATURAL RESOURCES

Bureau of Land and Water Resources

Southport Mall

P.O. Box 10631

Jackson, Mississippi 39209

WATER WELL DRILLERS LOG

CODED

SUNFLOWER  
R 141

2-25-86  
date well completed

IRRIGATION EQUIPMENT INC.  
firm name

SUNFLOWER  
county well located

LANDOWNER: JERRY NOBILE  
RT. 1, BOX 104 MOORHEAD, MS  
38761 (246-8294)  
(mailing address)

description of formations encountered	from	to
<u>CLAY</u>	<u>0</u>	<u>30</u>
<u>FINE SAND</u>	<u>30</u>	<u>40</u>
<u>COARSE SAND / PEA GRAVEL</u>	<u>40</u>	<u>100</u>

WELL LOCATION:

sec. 6 T. 18 N. R. 3 E  
4 miles WEST of MOORHEAD  
(distance) (direction) (nearest town)

WELL PURPOSE: FISH PONDS  
(home, irrigation, municipal, industrial)

WELL COMPLETION DATA:

- (1) diameter (inches) 12"
- (2) total depth (feet) 100'
- (3) static water level (feet) 28' below above top of ground.
- (4) casing STEEL 60'  
(material) (depth)  
12" if telescope see back.  
(size)
- (5) screen 40' 60'  
(length) (depth to top)  
12" STEEL  
(size) (material)
- (6) pump 25 1400  
(HP) (yield gpm)  
ELECTRIC  
(type power)
- (7) electric log NO  
(yes or no)  
STEEL  
(organization running log)
- (8) how well bottom plugged PLATE

CODED

RECEIVED  
MAR 5 1986

Department of Natural Resources  
Bureau of Land and Water Resources


DRILLERS REMARKS:

# 86055KFEO1

If well telescopes please sketch and show depths.

IRRIGATION EQUIPMENT  
601/887-2555  
INDIANOLA, MS

GROUND LEVEL

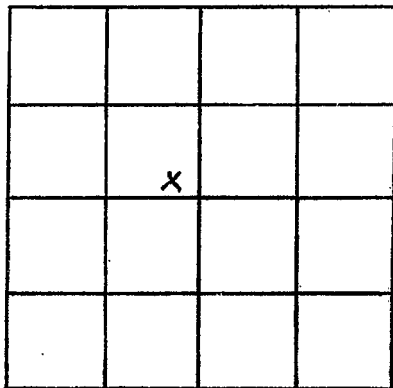

SECTION 6

Please indicate well location X.

ADDITIONAL INFORMATION

If more than one screen,  
show locations of each on sketch.