

MISSISSIPPI DEPARTMENT OF NATURAL RESOURCES

Bureau of Land and Water Resources

Southport Mall

P.O. Box 10631

Jackson, Mississippi 39209

WATER WELL DRILLERS LOG

Sunflower
86106MGS-01
R143

D-51-86

CODED

5-3 1986
 date well completed

Dyer Well, Inc
 firm name

Sunflower
 county well located

LANDOWNER: Paul Smith

Trans Fisheries, Inc

Box 88

moonhead, ms.

(mailing address)

WELL LOCATION:

sec. 9 T 18N S

R. 3 E W

_____ miles _____ of _____
 (distance) (direction) (nearest town)

WELL PURPOSE:

(home, irrigation, municipal, industrial)

WELL COMPLETION DATA:

(1) diameter (inches) 16
 (2) total depth (feet) 123

(3) static water level (feet) _____ below
 top of ground. above

(4) casing Steel
 (material) (depth)

16 if telescope see back.
 (size)

(5) screen _____ (length) _____ (depth to top)

16 Steel
 (size) (material)

(6) pump 600 3000
 (HP) (yield gpm)

_____ (type power)

(7) electric log _____ (yes or no)

_____ (organization running log)

(8) how well bottom plugged Plate

DRILLERS REMARKS:

86106MGS-01

description of formations encountered

from

to


Clay	0	24
fine sand	24	45
Sand & Gravel	45	90
fine sand	90	104
Sand & Gravel	104	123

CODED

RECEIVED
 MAY 14 1986
 Department of Natural Resources
 Bureau of Land & Water

If well telescopes please sketch and show depths.

GROUND LEVEL

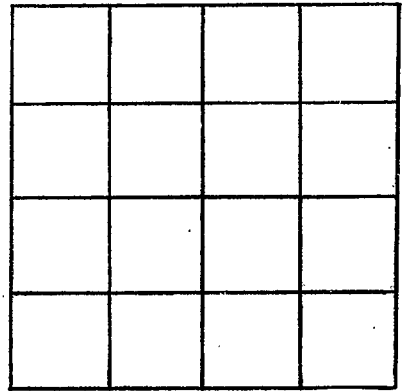

SECTION _____

Please indicate well location X.

ADDITIONAL INFORMATION

If more than one screen,
show locations of each on sketch.