

MISSISSIPPI DEPARTMENT OF NATURAL RESOURCES

Bureau of Land and Water Resources

Southport Mall

P.O. Box 10631

Jackson, Mississippi 39209

WATER WELL DRILLERS LOG

CODED

SUNFLOWER
R144
3-14-85

March 14 1985 date well completed Larry's well & pump firm name Sunflower county well located

LANDOWNER: Billy Stevens

description of formations encountered

from

to

Moorehead, ms
(mailing address)

clay	0	32
Fine sand	32	45
coarse sand & gravel	45	100

WELL LOCATION:

sec 1 T. 10 N. R. 3 E.
2 miles N.E. of Boond
(distance) (direction) (nearest town)

CODED

WELL PURPOSE:


(home, irrigation, municipal, industrial)

WELL COMPLETION DATA:

- (1) diameter (inches) 8"
- (2) total depth (feet) 100'
- (3) static water level (feet) 30' below above top of ground.
- (4) casing PVC, 60',
(material) (depth)
(size) if telescope see back.
- (5) screen 40', 60'
(length) (depth to top)
8", PVC
(size) (material)
- (6) pump 10, 700
(HP) (yield gpm)

(type power)
- (7) electric log no
(yes or no)

(organization running log)
- (8) how well bottom plugged PVC
cap

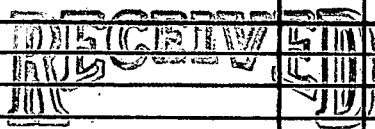


JUN 12 1985

Department of Natural Resources
Bureau of Land & Water

DRILLERS REMARKS:

If well telescopes please
sketch and show depths.

GROUND LEVEL

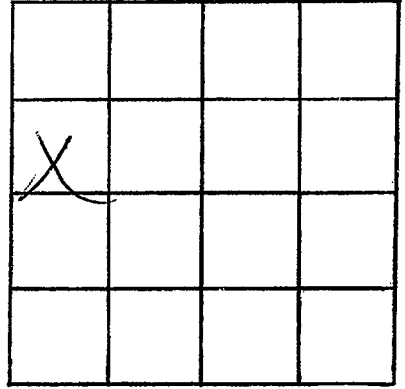

SECTION 1

Please indicate well location X.

ADDITIONAL INFORMATION

If more than one screen,
show locations of each on sketch.