

MISSISSIPPI DEPARTMENT OF NATURAL RESOURCES

Bureau of Land and Water Resources

Southport Mall

P.O. Box 10631

Jackson, Mississippi 39209

WATER WELL DRILLERS LOG

CODED

SUNFLOWER
R145
3-14-85

March 14 1985 Larry's well's pump ~~the~~ Sunflower
date well completed firm name county well located

LANDOWNER: Billy Stinson

description of formations encountered

from

to

| | | |
|----------------------|----|-----|
| Clay | 0 | 30 |
| Fine sand | 30 | 76 |
| coarse sand & gravel | 76 | 116 |

Moorehead, Mo.
(mailing address)

WELL LOCATION:

sec. 1 T. 18 N. R. 3 E. S. 2 W.
2 miles N.E. of Bard
(distance) (direction) (nearest town)

CODED

WELL PURPOSE:

(home, irrigation, municipal, industrial)

WELL COMPLETION DATA:

- (1) diameter (inches) 12"
- (2) total depth (feet) 116'
- (3) static water level (feet) 30' below top of ground.
- (4) casing Steel, 76' (material) (depth)

(size) if telescope see back.

- (5) screen 40' 76' (length) (depth to top)
- 12" Steel (size) (material)


- (6) pump 40 2000 (HP) (yield gpm)

(type power)

- (7) electric log 10 (yes or no)

(organization running log)

- (8) how well bottom plugged Steel Plate

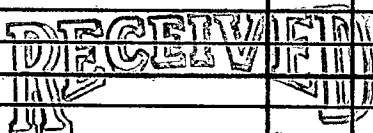


JUN 12 1986

Department of Natural Resources
Bureau of Land & Water Resources

DRILLERS REMARKS:

If well telescopes please sketch and show depths.

GROUND LEVEL

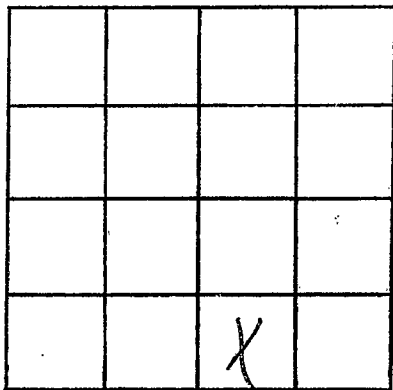

SECTION 1

Please indicate well location X.

ADDITIONAL INFORMATION

If more than one screen, show locations of each on sketch.