

SUNFLOWER
R 146

MISSISSIPPI DEPARTMENT OF NATURAL RESOURCES P
Bureau of Land and Water Resources
Southport Mall
P.O. Box 10631
Jackson, Mississippi 39209
WATER WELL DRILLERS LOG

CODED

420 1985 Larrys Well & Pump Sunflower
date well completed firm name county well located

LANDOWNER: Dave Roberts
Moorhead, MS.
(mailing address)


description of formations encountered	from	to
Clay	0	24
Fine sand	24	30
Coarse sand & gravel	30	100

WELL LOCATION:
sec. 28 T. 18 N R. 3 E
S 3 W
4 miles S of Moorhead
(distance) (direction) (nearest town)

CODED

WELL PURPOSE:
(home, irrigation, municipal, industrial)

- WELL COMPLETION DATA:
- (1) diameter (inches) 8"
 - (2) total depth (feet) 100'
 - (3) static water level (feet) 24' below top of ground.
 - (4) casing PVC, 60' (material) (depth)
If telescope see back. (size)
 - (5) screen 40' 60' (length) (depth to top)
8" PVC (size) (material)
 - (6) pump 15 (HP) 900 (yield gpm)
elect (type power)
 - (7) electric log No. (yes or no)
 - (organization running log)
 - (8) how well bottom plugged PVC CAP

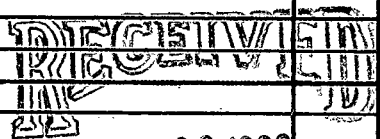


JUN 25 1980

Department of Natural Resources
Bureau of Land and Water Resources

DRILLERS REMARKS:

If well telescopes please sketch and show depths.

GROUND LEVEL

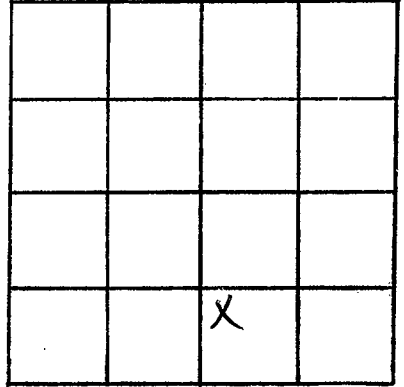

SECTION 28

Please indicate well location X.

ADDITIONAL INFORMATION

A series of horizontal lines for writing additional information, consisting of 20 lines.

If more than one screen, show locations of each on sketch.