

SUNFLOWER
R 147

MISSISSIPPI DEPARTMENT OF NATURAL RESOURCES
 Bureau of Land and Water Resources
 Southport Mall
 P.O. Box 10631
 Jackson, Mississippi 39209
WATER WELL DRILLERS LOG

CODED

March 3 19 86 Bruce Berryman Sunflower
 date well completed firm name county well located
 Greenwood, MS

LANDOWNER: Hayes Smith
Moorhead, MS 38761
 (mailing address)


WELL LOCATION:
 sec. 28 T 18 N R 5 E
 S W
4 miles South of Moorhead
 (distance) (direction) (nearest town)

WELL PURPOSE: Home
 (home, irrigation, municipal, industrial)

WELL COMPLETION DATA:
 (1) diameter (inches) 4" x 2"
 (2) total depth (feet) 1380'
 (3) static water level (feet) Flow ^{below} blk - 126' ^{above}
 top of ground.
 (4) casing 2" gal. 1248'
 (material) (depth)
 (size) if telescope see back.
 (5) screen 21' 1227'
 (length) (depth to top)
2" .010 ga. Stainless steel
 (size) (material)
 (6) pump 1 h.p. 18
 (HP) (yield gpm)
Electric
 (type power)
 (7) electric log NO
 (yes or no)
 (organization running log)
 (8) how well bottom plugged B.P.V.

description of formations encountered	from	to
Clay	0	20
Sand	20	60
Sand & gravel	60	220
Shale	220	340
Shale & Str. sand	340	460
Sand & str. shale	460	500
Sand	500	560
Shale	560	740
Brown sand	740	770
Shale	770	920
Shale & str. sand & hard rock	920	960
Shale & str. sand	960	1040
Sand	1040	1060
Rock shale & str. sand	1060	1300
Shale	1300	1360
Sand	1360	1380

CODED

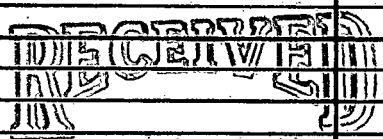


JUL 08 1986

Department of Natural Resources
 Bureau of Land & Water Resources

DRILLERS REMARKS:

If well telescopes please
sketch and show depths.

GROUND LEVEL

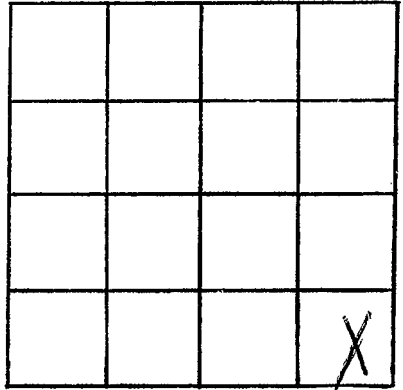

SECTION 28

Please indicate well location X.

ADDITIONAL INFORMATION

If more than one screen,
show locations of each on sketch.