

MISSISSIPPI DEPARTMENT OF NATURAL RESOURCES

Bureau of Land and Water Resources

Southport Mall

P.O. Box 10631

Jackson, Mississippi 39209

WATER WELL DRILLERS LOG


CODED

SUNFLOWER
R148

April 10 1986 Lamp Well's pump Sunflower
 date well completed firm name county well located

LANDOWNER: Paul Smith	description of formations encountered	from	to
YAZOO CITY MS (mailing address)			
WELL LOCATION: sec. 8 T. 18 N R. 3 E S 3 W 1 miles West of Morehead (distance) (direction) (nearest town)			
WELL PURPOSE: Fish Pond (home, irrigation, municipal, industrial)			
WELL COMPLETION DATA:			
(1) diameter (inches) 16"			
(2) total depth (feet) 116'			
(3) static water level (feet) 30' below top of ground.			
(4) casing Steel, 76' (material) (depth) if telescope see back. (size)			
(5) screen 40', 76' (length) (depth to top) 16" Steel (size) (material)			
(6) pump 60 3000 (HP) (yield gpm) (type power)			
(7) electric log no (yes or no) (organization running log)			
(8) how well bottom plugged Steel Plate			
DRILLERS REMARKS:			


CODED

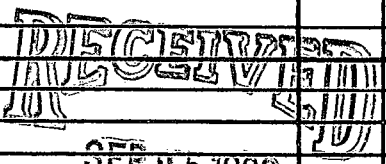

Department of Natural Resources
 Bureau of Land & Water Resources

If well telescopes please sketch and show depths.

GROUND LEVEL

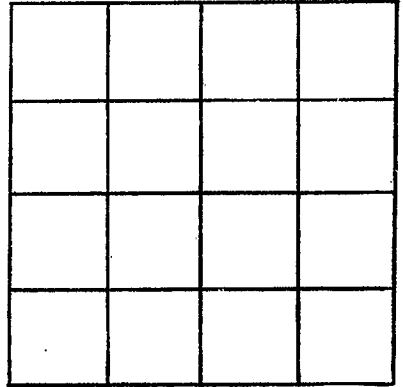

SECTION 8

Please indicate well location X.

ADDITIONAL INFORMATION

A series of horizontal lines providing space for additional information.

If more than one screen, show locations of each on sketch.