

MISSISSIPPI DEPARTMENT OF NATURAL RESOURCES

Bureau of Land and Water Resources

Southport Mall

P.O. Box 10631

Jackson, Mississippi 39209

WATER WELL DRILLERS LOG

CODED

SUNFLOWER
R150

3-25 1986 date well completed from name Ramp Well, pump Sunflower county well located

LANDOWNER: Harris Russell

description of formations encountered

from

to

Indiana, Mo.
(mailing address)

slay	0	30
Fine Sand	30	50
course sand & gravel	50	103

WELL LOCATION:

sec. 12 T. 18 N. R. 3 E. S. 3 W.
2 miles E of Mansfield
(distance) (direction) (nearest town)

WELL PURPOSE: FISH Pond
(home, irrigation, municipal, industrial)

WELL COMPLETION DATA:

- (1) diameter (inches) 1 1/2"
- (2) total depth (feet) 103
- (3) static water level (feet) 29' below top of ground.
- (4) casing Steel, 63' (material) (depth)
If telescope see back. (size)
- (5) screen 40' length, 63' depth to top. (length) (depth to top)
12' size, Steel (size) (material)
- (6) pump 30 HP, 1500 (yield gpm) (HP) (yield gpm)
E (type power)
- (7) electric log no (yes or no)
(organization running log)
- (8) how well bottom plugged Steel Plate

CODED

RECEIVED


SEP 25 1986

Department of Natural Resources
Bureau of Land & Water Resources

DRILLERS REMARKS:

If well telescopes please sketch and show depths.

GROUND LEVEL

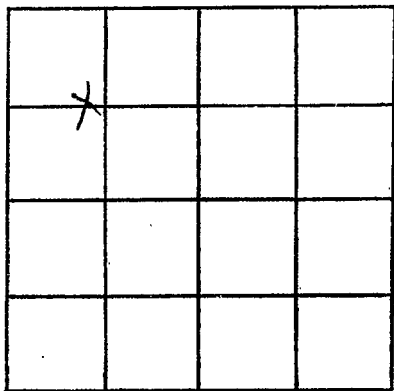

SECTION 12

Please indicate well location X.

ADDITIONAL INFORMATION

If more than one screen,
show locations of each on sketch.