

MISSISSIPPI DEPARTMENT OF NATURAL RESOURCES

Bureau of Land and Water Resources

Southport Mall

P.O. Box 10631

Jackson, Mississippi 39209

WATER WELL DRILLERS LOG

*Sunflower*  
 R 154  
 147 B

*Caled*

~~1987~~ 6-18 1987 *JL K IRRIGATION* *SUNFLOWER*  
 date well completed firm name county well located

LANDOWNER: *TRANSFISHERS*  
*MOOREHEAD, MISS*  
 (mailing address)

description of formations encountered	from	to
<i>CLAY</i>	<i>0</i>	<i>24</i>
<i>FINE SAND</i>	<i>24</i>	<i>42</i>
<i>COARSE SAND &amp; GRAVEL</i>	<i>46</i>	<i>116</i>

WELL LOCATION:  
 sec. *17* T. *18* N R. *3* E  
*1 1/2* miles *W* of *MOOREHEAD*  
 (distance) (direction) (nearest town)

WELL PURPOSE: *FIS*  
 (home, irrigation, municipal, industrial)

WELL COMPLETION DATA:

(1) diameter (inches) *16"*

(2) total depth (feet) *116'*

(3) static water level (feet) *31* below  
 top of ground.

(4) casing *Steel*, *86*  
 (material) (depth)  
*16"* if telescope see back.  
 (size)

(5) screen *40'*, *86*  
 (length) (depth to top)  
*16"*, *Steel*  
 (size) (material)

(6) pump *50*, *2800*  
 (HP) (yield gpm)  
*Diesel*  
 (type power)

(7) electric log *NO*  
 (yes or no)

(organization running log)

(8) how well bottom plugged *Plated*

RECEIVED


NOV 12 1987

Department of Natural Resources  
 Bureau of Land & Water Resources

DRILLERS REMARKS:

If well telescopes please sketch and show depths.

GROUND LEVEL

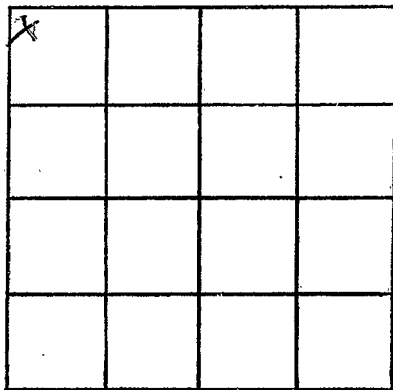

SECTION 17

Please indicate well location X.

ADDITIONAL INFORMATION

If more than one screen,  
show locations of each on sketch.