

MISSISSIPPI DEPARTMENT OF NATURAL RESOURCES

Bureau of Land and Water Resources

Southport Mall

P.O. Box 10631

Jackson, Mississippi 39209

WATER WELL DRILLERS LOG

Sumflow  
R 155  
147B

Caddo

9 1987 J & K Irrigation Sumflow  
 date well completed firm name county well located

LANDOWNER: TRAV Fishers  
Mootehead, Miss  
 (mailing address)

description of formations encountered	from	to
CLAY	0	19
Fine SAND	19	42
COARSE SAND & GRAVEL	42	115

WELL LOCATION:  
 sec 7 T 18 N R 3 E  
 & W  
2 miles W of Mootehead  
 (distance) (direction) (nearest town)

WELL PURPOSE: Fish  
 (home, irrigation, municipal, industrial)

WELL COMPLETION DATA:

(1) diameter (inches) 16

(2) total depth (feet) 115

(3) static water level (feet) 35 below ~~above~~ top of ground.

(4) casing Steel 85  
 (material) (depth)  
16" if telescope see back.  
 (size)

(5) screen 40' 85'  
 (length) (depth to top)  
16 Steel  
 (size) (material)

(6) pump 50 2800  
 (HP) (yield gpm)  
Diesel  
 (type power)

(7) electric log NO  
 (yes or no)  
 (organization running log)

(8) how well bottom plugged plate


RECEIVED  
 NOV 12 1987

Department of Natural Resources  
 Bureau of Land & Water Resources

DRILLERS REMARKS:

If well telescopes please sketch and show depths.

GROUND LEVEL

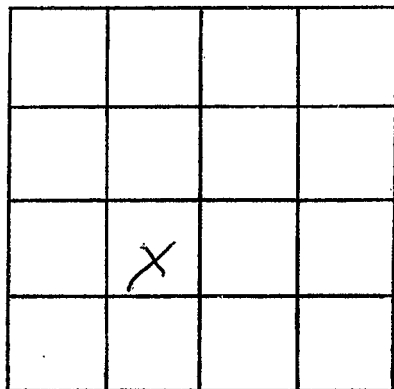

SECTION 7

Please indicate well location X.

ADDITIONAL INFORMATION

If more than one screen,  
show locations of each on sketch.