

MISSISSIPPI DEPARTMENT OF NATURAL RESOURCES

Bureau of Land and Water Resources

Southport Mall

P.O. Box 10631

Jackson, Mississippi 39209

WATER WELL DRILLERS LOG

Sunflower  
R 157  
147B

Caled

~~8-8-19~~ 8-19 1987 JLK Irrigation SUNFLOWER  
 date well completed firm name county well located

LANDOWNER: THOMAS Fishers  
Moorehead, MISS  
 (mailing address)

description of formations encountered	from	to
<u>CLAY</u>	<u>0</u>	<u>21</u>
<u>Fine Sand</u>	<u>21</u>	<u>43</u>
<u>Coarse Sand (Gravel)</u>	<u>43</u>	<u>117</u>

WELL LOCATION:  
 sec. 9 T. 18 N R. 3 E  
34 miles SW of Moorehead  
 (distance) (direction) (nearest town)

WELL PURPOSE: Fish  
 (home, irrigation, municipal, industrial)

- WELL COMPLETION DATA:
- (1) diameter (inches) 16"
  - (2) total depth (feet) 117
  - (3) static water level (feet) 36 below above top of ground.
  - (4) casing Steel, 87  
 (material) (depth)  
16" If telescope see back.  
 (size)
  - (5) screen 40', 87  
 (length) (depth to top)  
16", Steel  
 (size) (material)
  - (6) pump 50, 2800  
 (HP) (yield gpm)  
Electric  
 (type power)
  - (7) electric log NO  
 (yes or no)
  - (8) how well bottom plugged Plate

RECEIVED  
 RECEIVED


NOV 12 1987

Department of Natural Resources  
 Bureau of Land & Water Resources

DRILLERS REMARKS:

If well telescopes please sketch and show depths.

GROUND LEVEL

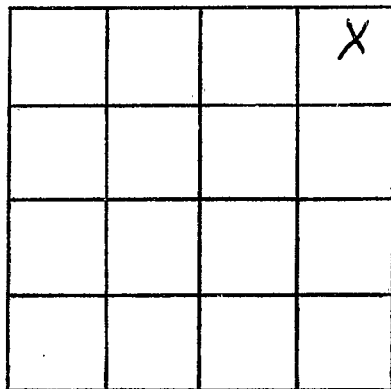

SECTION 9

Please indicate well location X.

ADDITIONAL INFORMATION

If more than one screen,  
show locations of each on sketch.