

COCKFIELD

MISSISSIPPI DEPARTMENT OF NATURAL RESOURCES

Bureau of Land and Water Resources

COUNTY WELL LOCATED	
Sagam Parish	
WELL NUMBER	CODING
R176	✓
DATE WELL COMPLETED	
92	

PERMIT NUMBER
NAME OF DRILLING FIRM
LAMBERT

P.O. Box 10631
Jackson, Mississippi 39209
WATER WELL DRILLERS LOG

NAME & MAILING ADDRESS OF LANDOWNER		
Besda Anderson		
moorhead, ms.		
WELL LOCATION: SEC TOWNSHIP RANGE		
4 18 ^N 3 ^E		
DISTANCE DIRECTION NEAREST TOWN		
1 Miles N of Moorhead		
OTHER LANDMARK		
WELL PURPOSE: Home, Irrigation, Municipal, Industrial, Fish Pond, etc.		

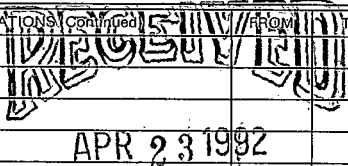
PUMP DATA		
PUMP TYPE (Circle One):		
<input checked="" type="radio"/> Submersible, <input type="radio"/> Turbine, <input type="radio"/> Jet <input type="radio"/> Flowing Well,		
Other (Describe)		
POWER TYPE (Circle One):		
<input checked="" type="radio"/> Electric, <input type="radio"/> Tractor, <input type="radio"/> Diesel, <input type="radio"/> Gasoline, <input type="radio"/> Butane,		
Other (Describe) H/P 1/2		
Pump Capacity (GPM)	No. of Stages	Setting Depth
30	10	105 FT.
PUMP TEST		
Well yielded _____ GPM with		
a drawdown of _____ ft.		
after _____ hours of pumping		

WELL DATA		
Well Depth	Casing Diameter (In.)	Casing Length (Ft.)
460	4 X 2	440
Type of Casing	Hole Depth	Depth to Static Water Level
PVC	570	42
TYPE OF COMPLETION: (Circle One or More):		
<input checked="" type="radio"/> Gravel Packed, <input type="radio"/> Underreamed, <input type="radio"/> Telescoped,		
<input checked="" type="radio"/> Natural Development, <input type="radio"/> Open Hole, <input type="radio"/> Other		
(Describe)		
Top of Lap Pipe or Reduction in Casing		
FEET IF TELESCOPED OR MORE THAN ONE SCREEN: USE BACK PAGE		

LOG DATA	
TYPE OF LOG RUN (Circle One):	
<input type="radio"/> No. Log Run, <input type="radio"/> Electric, <input type="radio"/> Gamma Ray, <input type="radio"/> Density, <input type="radio"/> Sonic, <input type="radio"/> Neutron,	
Other (Describe)	
Name of Organization Running Log	

SCREEN DATA		
Diameter - Inches	Length - Feet	Slot Size - Inches
2"	20'	10
Screen Type	Depth to Bottom - Feet	
PVC var.	460-440	

GEOLOGIC DATA (Office Use Only)			
Surface Elev.	Geologic Unit	Unit Thickness	Depth to Top
Subs. SWL	Date	Analysis	Aquifer Test
Driller's Remarks			

DESCRIPTION OF FORMATIONS ENCOUNTERED	FROM	TO	FORMATIONS (continued)	FROM	TO
Clay	0	18			
Sand	18	65			
gravel	65	94			
Clay	94	120			
Clay & sand	120	380			
Sand	380	460			
Dept. of Environmental Quality Bureau of Land & Water Resources					
IF MORE SPACE IS NEEDED, USE BACK					

If well telescopes please
sketch and show depths.

GROUND LEVEL

140 4"

440 2"

460 2" screen

		X	

SECTION 4

Please indicate well location X.

ADDITIONAL INFORMATION

If more than one screen,
show location of each on sketch.