

SUNFLOWER
 R 2002
 6/12/78

MISSISSIPPI
 BOARD OF WATER COMMISSIONERS
 416 North State Street
 Jackson, Mississippi 39201

WATER WELL DRILLERS LOG

BUTANE GAS COMPANY

OF GREENWOOD

Sunflower
 county well located

6-12-78 19
 date well completed

LANDOWNER:
 Roberts Bros.
 Moorhead
 (mailing address)

description of formations encountered	from	to
Clay	0	35
Sand	35	60
SAND + GRAVEL	60	83


WELL LOCATION:
 sec. 1 T. 18 N R. 3 E
 S W
 2 miles E of Moorhead
 (distance) (direction) (nearest town)

WELL PURPOSE: Home
 (home, irrigation, municipal, industrial)

- WELL COMPLETION DATA:
- (1) diameter (inches) 4"
 - (2) total depth (feet) 80
 - (3) static water level (feet) 18 below above-top of ground.
 - (4) casing PVC 60
 (material) (depth)
 4" If telescope see back.
 (size)
 - (5) screen 20' 60
 (length) (depth to top)
 4" PVC
 (size) (material)
 - (6) pump 1/2 10
 (HP) (yield gpm)
 Elec.
 (type power)
 - (7) electric log No
 (yes or no)
- (organization running log)

(8) how well bottom plugged
 Back Pressure Valve

DRILLERS REMARKS:

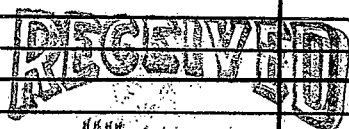


JUN 7 1978

MISS. Bd. OF WATER COMMISSIONERS

If well telescopes please sketch and show depths.

GROUND LEVEL

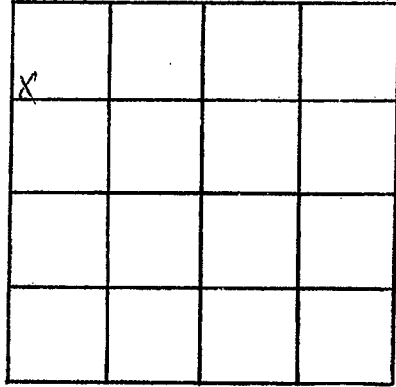

SECTION 1

Please indicate well location X.

ADDITIONAL INFORMATION

Lined area for additional information.

If more than one screen, show locations of each on sketch.