

SUNFLOWER
 R 2003
 10-23-78

MISSISSIPPI
 BOARD OF WATER COMMISSIONERS
 416 North State Street
 Jackson, Mississippi 39201

WATER WELL DRILLERS LOG

BUTANE GAS COMPANY

OF GREENWOOD
 firm name

Sunflower
 county well located

10-23-78
 date well completed

LANDOWNER:
 Eddie Hobbs
 Moorhead
 (mailing address)

WELL LOCATION:
 sec. 23 T-18 N R-3 E
 2 1/2 miles SE of Moorhead
 (distance) (direction) (nearest town)

WELL PURPOSE: Home
 (home, irrigation, municipal, industrial)

WELL COMPLETION DATA:

(1) diameter (inches) 4 1/2

(2) total depth (feet) 933

(3) static water level (feet) 5 below top of ground.

(4) casing Steel 903
 (material) (depth)
 4 1/2 if telescope see back.
 (size)

(5) screen 30 903
 (length) (depth to top)
 2" STAINLESS
 (size) (material)

(6) pump 1 20
 (HP) (yield gpm)
 Elec.
 (type power)

(7) electric log No
 (yes or no)
 (organization running log)

description of formations encountered	from	to
Clay	0	15
Sand	15	55
Gravel	55	145
Sand + Clay	145	190
Clay	190	210
Sand	210	295
Sandy Shale	295	325
Sand	325	405
Sand + Shale streaks	405	480
Gummy Shale	480	570
Sandy Shale	570	610
Gummy Shale	610	715
Sand	715	735
Shale	735	750
Gummy Shale + Rock	750	895
Green Sand	895	935
Shale + Rock	935	970
Sand, Shale + Rock	970	985
Fine Sand	985	1010
Rock + Shale	1010	1023

RECEIVED
 OCT 25 1978

MISS. BD. OF WATER COMM.

DRILLERS REMARKS:
 BACK PRESSURE VALVE


If well telescopes please sketch and show depths.

GROUND LEVEL

105' - 4" CASING →

798' - 2" CASING →

30' - 2" SCREEN →

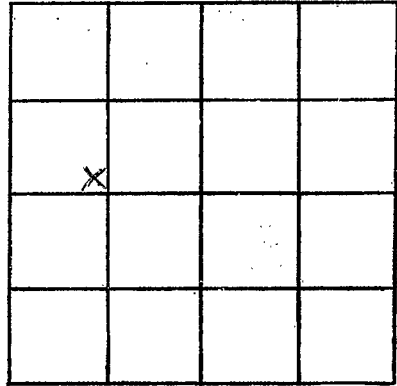

SECTION 23

Please indicate well location X.

ADDITIONAL INFORMATION

If more than one screen,
show locations of each on sketch.