

SUNFLOWER

2004 R

11-27-78

MISSISSIPPI BOARD OF WATER COMMISSIONERS
416 North State Street
Jackson, Mississippi 39201

WATER WELL DRILLERS LOG

11-27

1978 Schultz Drilling Co.

SUNFLOWER

date well completed

firm name

county well located

LANDOWNER: W. Jimbs

Moorehead MS.

38761

(mailing address)

description of formations encountered

from

to

Clay	0	18
COARSE Sand	18	30
COARSE Sand + Gravel	30	50

WELL LOCATION:

sec. 15 T-18 R-3 E S-3 W Moorehead
(distance) miles (direction) of (nearest town)

WELL PURPOSE: HOME
(home, irrigation, municipal, industrial)

WELL COMPLETION DATA:

- (1) diameter (inches) 2 in.
- (2) total depth (feet) 50 ft.
- (3) static water level (feet) 14 below top of ground.
- (4) casing PVC 40 ft. (material) (depth)
2 in. (size) If telescope see back.
- (5) screen 10 ft. 40 ft. (length) (depth to top)
2 in. PVC (size) (material)
- (6) pump 1/2 8 (HP) (yield gpm)
ele (type power)
- (7) electric log NO (yes or no)

(organization running log)

(8) how well bottom plugged PVC Cap


DRILLERS REMARKS:

RECEIVED
DEC 27 1978

MISS. BD. OF WATER COMMISSIONERS

If well telescopes please sketch and show depths.

GROUND LEVEL

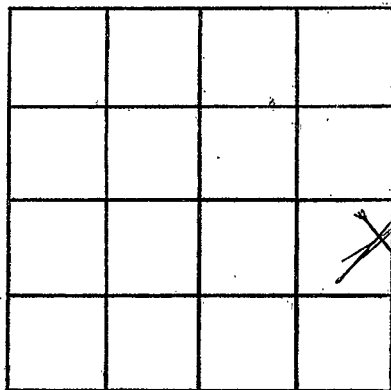

SECTION _____

Please indicate well location X.

ADDITIONAL INFORMATION

If more than one screen,
show locations of each on sketch.