

MISSISSIPPI DEPARTMENT OF NATURAL RESOURCES

Bureau of Land and Water Resources

Southport Mall

P.O. Box 10631

Jackson, Mississippi 39209

WATER WELL DRILLERS LOG

BUTANE GAS CO. OF GREENWOOD

POST OFFICE BOX 1135

GREENWOOD, MISS. 38930

Sunflower

county well located

SUNFLOWER
R 2005
8-27-81


8-27 1981
date well completed

LANDOWNER:	description of formations encountered	from	to
<i>Mr Pleasant</i>	<i>Clay</i>	0	30
<i>M.R. Church</i> (mailing address)	<i>Sand + Gravel</i>	30	55
WELL LOCATION: sec. <u>1</u> T <u>14</u> N R <u>3</u> E <u>2</u> miles <u>E</u> of <u>Marshall</u> (distance) (direction) (nearest town)	<i>Gravel</i>	55	70
WELL PURPOSE: <u>Domestic</u> (home, irrigation, municipal, industrial)			
WELL COMPLETION DATA:			
(1) diameter (inches) <u>4"</u>			
(2) total depth (feet) <u>102</u>			
(3) static water level (feet) <u>35</u> <u>below</u> top of ground.			
(4) casing <u>PVC</u> , <u>82</u> (material) (depth)			
<u>4"</u> (size) If telescope see back.			
(5) screen <u>PVC</u> , <u>82</u> (length) (depth to top)			
<u>4"</u> , <u>PVC</u> (size) (material)			
(6) pump <u>1/2</u> , <u>10</u> (HP) (yield gpm)			
<u>Electric</u> (type power)			
(7) electric log <u>NO</u> (yes or no)			
(organization running log)			
(8) how well bottom plugged <u>Bottom covered with</u>			
DRILLERS REMARKS: <u>Richard</u>			

DEPT. OF NATURAL RESOURCES
BUREAU OF LAND & WATER RESOURCES


SEP 18 1981

RECEIVED

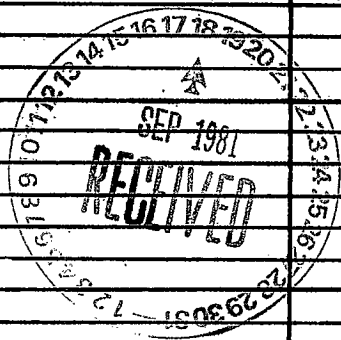

If well telescopes please sketch and show depths.

GROUND LEVEL

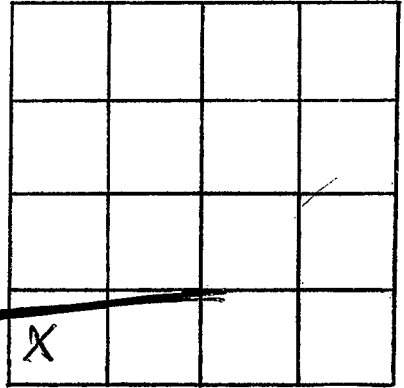

SECTION 1

Please indicate well location X.

ADDITIONAL INFORMATION

If more than one screen,
show locations of each on sketch.