

If well telescopes please sketch and show depths.


GROUND LEVEL

			x

SECTION 33

Please indicate well location X.

ADDITIONAL INFORMATION

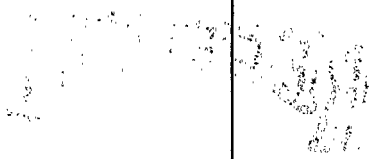

If more than one screen, show location of each on sketch.