

SUNFLOWER
 R 2047 12
 9-3-76

MISSISSIPPI
 BOARD OF WATER COMMISSIONERS
 416 North State Street
 Jackson, Mississippi 39201

CODED

WATER WELL DRILLERS LOG

9-3-76 19 BUIANE GAS CO. OF GREENWOOD Sunflower
 date well completed firm name county well located

LANDOWNER:	description of formations encountered	from	to
A. K. Maxwell			
Moorhead	Black Gumbo	25	40
(mailing address)	Sand	40	65
WELL LOCATION:	Sand & Gravel	65	85
sec. <u>21</u> T <u>18</u> N R <u>3</u> E	Sand	85	93
S S W			
<u>3</u> miles <u>S</u> of <u>Moorhead</u>			
(distance) (direction) (nearest town)			
WELL PURPOSE: <u>IR</u>			
(home, irrigation, municipal, industrial)			
WELL COMPLETION DATA:			
(1) diameter (inches) <u>12"</u>			
(2) total depth (feet) <u>93</u>			
(3) static water level (feet) <u>15</u> below/above top of ground.			
(4) casing <u>Steel</u> <u>53</u>			
(material) (depth)			
<u>12"</u> If telescope see back.			
(size)			
(5) screen <u>40</u> <u>53</u>			
(length) (depth to top)			
<u>12"</u> <u>Steel</u>			
(size) (material)			
(6) pump <u>60</u> <u>1800</u>			
(HP) (yield gpm)			
<u>Diesel</u>			
(type power)			
(7) electric log <u>No</u>			
(yes or no)			
(organization running log)			
(8) how well bottom plugged <u>Steel Plate</u>			
DRILLERS REMARKS:			


CODED

RECEIVED
 SEP - 7 1976

MISS. BD. OF WATER COMMISSIONERS

If well telescopes please sketch and show depths.

GROUND LEVEL

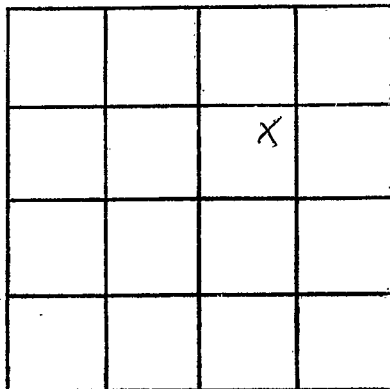

SECTION 21

Please indicate well location X.

ADDITIONAL INFORMATION

If more than one screen,
show locations of each on sketch.