

**MISSISSIPPI
BOARD OF WATER COMMISSIONERS**
416 North State Street
Jackson, Mississippi 39201

WATER WELL DRILLERS LOG
BUTANE GAS CO. OF GREENWOOD

Sunflower
56
5-14-69

date well completed 5/14/69 19 69
 well name GREENWOOD, MISSISSIPPI
 county well located Sunflower

LANDOWNER:

James Lee
Greenville, Miss.
(mailing address)

description of formations encountered

| | from | to |
|----------------------|-----------|-----------|
| <u>clay</u> | <u>0</u> | <u>18</u> |
| <u>Sand</u> | <u>18</u> | <u>30</u> |
| <u>Sand + GRAVEL</u> | <u>30</u> | <u>83</u> |

WELL LOCATION:

sec. 36 T. 17 N. R. 5 E.
 (distance) 6 miles W of Inverness
 (direction) (nearest town)

WELL PURPOSE:

Home
(home, irrigation, municipal, industrial)

WELL COMPLETION DATA:

- (1) diameter (inches) 2
- (2) total depth (feet) 83
- (3) static water level (feet) 18 below top of ground.
- (4) casing Steel (73 depth),
2 (size) if telescope see back.
- (5) screen 10 (93 depth to top),
2" (PVC material)
- (6) pump 3/4 (10 yield gpm),
Elec. (type power)
- (7) electric log no (yes or no)

(organization running log)

- (8) how well bottom plugged Lead Plug


DRILLERS REMARKS:

OK

JUN 4 1969
 MISS. BD. OF
 WATER COM.

If well telescopes please sketch and show depths.

GROUND LEVEL

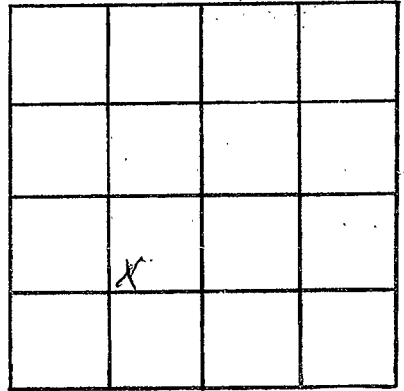

SECTION 36

Please indicate well location X.

ADDITIONAL INFORMATION

If more than one screen,
show locations of each on sketch.