

Sunflower  
S 7  
4-9-70

MISSISSIPPI  
BOARD OF WATER COMMISSIONERS  
416 North State Street  
Jackson, Mississippi 39201

COPIED

WATER WELL DRILLERS LOG

11-9 1970 Railway Drilling Co. Sunflower  
date well completed firm name county well located

LANDOWNER: Ruby Lee Livingston  
Indianola  
Miss.  
(mailing address)

description of formations encountered	from	to
Clay	0	15
Sand	15	70
Gravel	70	138
Mud	138	235
Sand	235	280
Mud	280	380
Sand	380	395
Mud	395	400
Sand	400	430

WELL LOCATION:  
sec. 20 T. 17 N. R. 5 E  
W  
2 miles E of Bourbon  
(distance) (direction) (nearest town)

WELL PURPOSE: home  
(home, irrigation, municipal, industrial)

- WELL COMPLETION DATA:
- (1) diameter (inches) 2
  - (2) total depth (feet) 430
  - (3) static water level (feet) 20 below top of ground.
  - (4) casing steel 424  
(material) (depth)  
2"  
(size) If telescope see back.
  - (5) screen 6, 424  
(length) (depth to top)  
2", Stainless Steel  
(size) (material)
  - (6) pump 1/3 5  
(HP) (yield gpm)  
Elec  
(type power)
  - (7) electric log No  
(yes or no)

(organization running log)

(8) how well bottom plugged  
Back pressure valve

DRILLERS REMARKS:


APR 10 1970

MISS. DD. OF  
WATER COMM.

COPIED

If well telescopes please sketch and show depths.

GROUND LEVEL

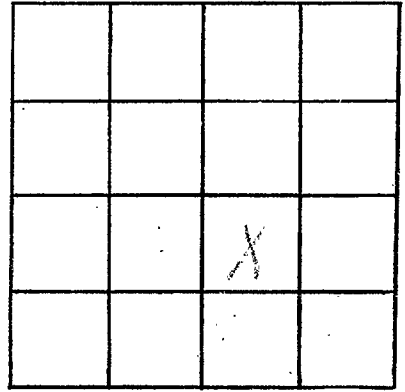

SECTION \_\_\_\_\_

Please indicate well location X.

ADDITIONAL INFORMATION

If more than one screen,  
show locations of each on sketch.