

SUNFLOWER MISSISSIPPI BOARD OF WATER COMMISSIONERS


Q510
6-22-65

WATER WELL DRILLERS LOG

CODED

Date: 6/22, 1965, Driller: Pauley Drilling Co. County: Washington
(Name)

(1) Owner of Land:	Description & Color of Materials Sand, Clay, Red Clay, Shell, etc.	Thick- ness Feet	Depth Feet
(Name) <u>Robt. Barnett</u> (Address) <u>Indianola, Miss.</u>	<u>Clay</u>		<u>15</u>
(2) Location: <u>1/4, 1/4, Sec. 4 T. 17 R. 6</u>	<u>Sand</u>		<u>90</u>
(distance) <u>6</u> miles <u>S</u> (direction) <u>Indianola</u> (Nearest Town)	<u>Sand + gravel</u>		<u>135</u>
(3) Topography: <u>Flat</u>	<u>Mud</u>		<u>369</u>
(4) Purpose of Well: <u>Domestic</u>	<u>Sand</u>		<u>451</u>
(Domestic Irrigation, Municipal, Industrial, Other)	<u>Mud</u>		<u>571</u>
Information upon completion of well:	<u>Sand + Mud</u>		<u>640</u>
(1) Diameter: <u>4X3X2 1/2</u> inches.	<u>Mud</u>		<u>770</u>
(2) Total Depth: <u>1757</u> feet.	<u>Sand</u>		<u>912</u>
(3) Water Level: <u>45</u> feet above ground.	<u>Mud</u>		<u>1412</u>
(4) Cased to: <u>all way</u> Size: <u>4X3X2 1/2</u>	<u>Rock</u>		<u>1414</u>
(5) Screen: Size: <u>2 1/2</u> , Length: <u>30 ft</u>	<u>Mud</u>		<u>1449</u>
(6) Were any formations sealed against pollution?	<u>Rock</u>		<u>1453</u>
_____ yes, <u>X</u> no.	<u>Mud</u>		<u>1571</u>
YES depth of formation _____	<u>Sand</u>		<u>1542</u>
by _____	<u>Mud</u>		<u>1602</u>
Drillers Remarks: _____	<u>Rocks</u>		<u>1621</u>
_____	<u>Mud</u>		<u>1626</u>
_____	<u>Rock</u>		<u>1628</u>
_____	<u>Mud</u>		<u>1660</u>
_____	<u>Green sand</u>		<u>1683</u>
_____	<u>Mud</u>		<u>1700</u>
_____	<u>Sand</u>		<u>1757</u>

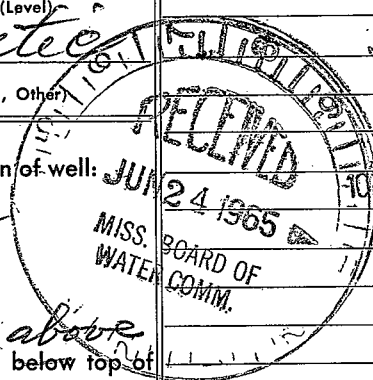

CODED

(Use Back Side)

Well No.

