

511

4-15-66

WATER WELL DRILLERS LOG

CODED

Date: 4/15, 1966, Driller: Bailey Drilling Co County: Washington
(Name)

(1) Owner of Land: Laura Hull
(Name)
Indianola, Miss.
(Address)

(2) Location: 1/4, 1/4, Sec. 20 T17 R5,
8 miles S of Indianola
(distance) (direction) (Nearest Town)

(3) Topography: Flat
(Hilly) (Flat) (Level)

(4) Purpose of Well: domestic
(Domestic Irrigation
Municipal, Industrial, Other)

Description & Color of Materials Sand, Clay, Red Clay, Shell, etc.	Thick- ness Feet	Depth Feet
Clay		20
Sand		80
Gravel		130
Mud		631
Sand		671
Mud		691
Sand		771
Mud		900
Rock		901
Mud		931
Sand + Mud		971
Mud		1000
Sand		1035
Mud + rocks		1673
Rocks + green sand		1682
Green sand		1697
Mud + rocks		1796
Sand		1830

Information upon completion of well:

(1) Diameter 4x2 1/2 x 2 inches.

(2) Total Depth 1830 feet.


(3) Water Level 45 feet below top of ground. above

(4) Cased to all way Size 4x2 1/2 x 2

(5) Screen: Size 2", Length 30ft.

(6) Were any formations sealed against pollution?
no

CODED

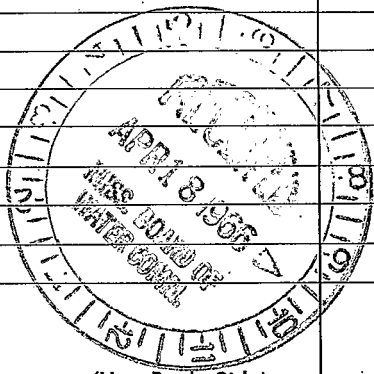

If YES depth of formation _____

Why _____

Drillers Remarks: _____

(Use Back Side)

Well No.

[The page contains extremely faint and illegible text, likely bleed-through from the reverse side of the document. No specific content can be transcribed.]