

SUNFLOWER
513
11-18-71

MISSISSIPPI
 BOARD OF WATER COMMISSIONERS
 416 North State Street
 Jackson, Mississippi 39204

CODED

WATER WELL DRILLERS LOG

11/18 1971 Bailey Drilling Co. Sunflower
 date well completed firm name county/well located

LANDOWNER: J. B. Lee
Indianola
Miss.
 (mailing address)

description of formations encountered	from	to
<u>Clay</u>	<u>0</u>	<u>10</u>
<u>Sand</u>	<u>10</u>	<u>65</u>
<u>Gravel</u>	<u>65</u>	<u>80</u>

WELL LOCATION:
 sec. 4 T. 17 N R. 5 W
5 miles S of Indianola
 (distance) (direction) (nearest town)

WELL PURPOSE: Farm
 (home, irrigation, municipal, industrial)

- WELL COMPLETION DATA:
- (1) diameter (inches) 2"
 - (2) total depth (feet) 80
 - (3) static water level (feet) 20 below top of ground.
 - (4) casing Steel, 76',
 (material) (depth)
2" if telescope see back.
 (size)
 - (5) screen 4, 76'
 (length) (depth to top)
2", Stainless Steel
 (size) (material)
 - (6) pump 1/2, 6
 (HP) (yield gpm)
Elec
 (type power)
 - (7) electric log No
 (yes or no)

CODED

NOV 22 1971

STATE OF
 MISSISSIPPI
 DEPARTMENT OF
 AGRICULTURE


(organization running log)

(8) how well bottom plugged
Back pressure Valve

DRILLERS REMARKS:

If well telescopes please sketch and show depths.

GROUND LEVEL

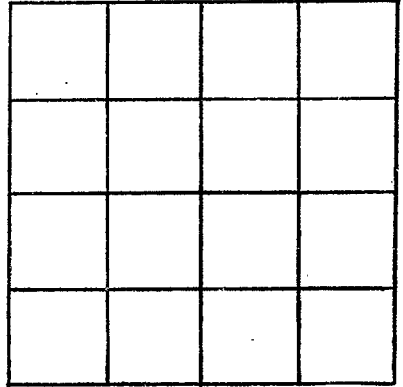

SECTION _____

Please indicate well location X.

ADDITIONAL INFORMATION

If more than one screen,
show locations of each on sketch.