

SUNFLOWER
S 15
4-6-75

MISSISSIPPI
 BOARD OF WATER COMMISSIONERS
 416 North State Street
 Jackson, Mississippi 39201

WATER WELL DRILLERS LOG

CODED
 Sunflower

April 6, 1975 Singer-Layne Central Div.
 date well completed firm name

county well located


| LANDOWNER: R. D. Mallette P. O. Box 578 Indianola, MS (mailing address) | description of formations encountered | from | to |
|--|---------------------------------------|------|-----|
| | | | |
| | Sandy Clay | 17 | 37 |
| | Sand & Pea Gravel | 37 | 92 |
| WELL LOCATION: sec. 6 T 17 N R 5 W | Fine Sand | 92 | 97 |
| 4 miles west of Inverness (distance) (direction) (nearest town) | Coarse Sand | 97 | 117 |
| WELL PURPOSE: irrigation (home, irrigation, municipal, industrial) | | | |
| WELL COMPLETION DATA: | | | |
| (1) diameter (inches) 16" | | | |
| (2) total depth (feet) 117' | | | |
| (3) static water level (feet) 14 below top of ground. | | | |
| (4) casing steel 57' (material) (depth) 16" If telescope see back. (size) | | | |
| (5) screen 60' 57' (length) (depth to top) 16" steel (size) (material) | | | |
| (6) pump 60 2800 (HP) (yield gpm) engine (type power) | | | |
| (7) electric log no (yes or no) | | | |
| (organization running log) | | | |
| (8) how well bottom plugged with plate | | | |
| DRILLERS REMARKS: | | | |

RECEIVED
APR 12 1975

MAY 12 1975

If well telescopes please sketch and show depths.

GROUND LEVEL

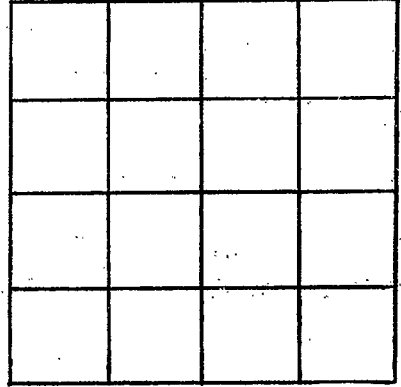

SECTION _____

Please indicate well location X.

ADDITIONAL INFORMATION

If more than one screen, show locations of each on sketch.