

CODED

MISSISSIPPI
BOARD OF WATER COMMISSIONERS
416 North State Street
Jackson, Mississippi 39201

WATER WELL DRILLERS LOG

Sunflower

SUNFLOWER
S 18
2-18-75

Feb. 18, 1975
date well completed

Dyer-Sullivan
firm name

Hampton
county well located

LANDOWNER: K.D. PEARSON + Sons

description of formations encountered

from to

P.O. Box 241

Isola, Miss. 38754
(mailing address)

0-144
FINE SAND
SAND & GRAVEL

0 30
30 74
74 114

WELL LOCATION:

sec. 34 T 17 N R 5 E 15th
S W
5 miles SW of Inverness
(distance) (direction) (nearest town)

WELL PURPOSE: Irrigation
(home, irrigation, municipal, industrial)

WELL COMPLETION DATA:

- (1) diameter (inches) 16"
- (2) total depth (feet) 114'
- (3) static water level (feet) 11 below above top of ground.
- (4) casing BIC Iron 74' (material) (depth)
16" (size) if telescope see back.
- (5) screen 40' 74' (length) (depth to top)
16 BIC Inset (size) (material)
- (6) pump 100 3000 (HP) (yield gpm)
Diesel (type power)
- (7) electric log No (yes or no)
- (organization running log)
- (8) how well bottom plugged Plate


DRILLERS REMARKS: [Stamp: DRILLERS REMARKS, OCT 10 1975]

DRILLERS REMARKS:

MISS. BOARD OF WATER COMMISSIONERS

If well telescopes please sketch and show depths.

GROUND LEVEL

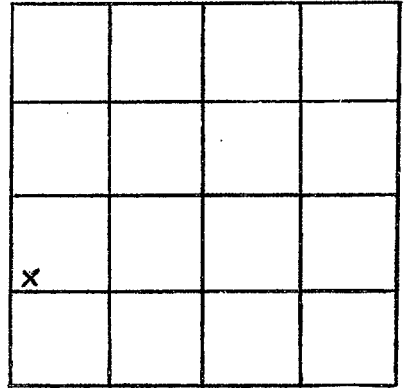

SECTION 34

Please indicate well location X.

ADDITIONAL INFORMATION

If more than one screen,
show locations of each on sketch.