

SUNFLOWER
 S 22
 4/5/78

MISSISSIPPI
 BOARD OF WATER COMMISSIONERS
 416 North State Street
 Jackson, Mississippi 39201

CODED

WATER WELL DRILLERS LOG

Sunflower

April 5 19 28 Dyer Well & Irrigation Sunflower
 Date well completed firm name county well located

LANDOWNER: Paul Moon	description of formations encountered	from	to
R.R. 2			
Isola, Miss. (mailing address)	Clay FINE SAND CODED SAND + GRAVEL	0	31 32 62 63 113

WELL LOCATION:
 sec. 35 T. 17 N. R. 5 E
 7 miles West of Isola
 (distance) (direction) (nearest town)

WELL PURPOSE: Irrigation
 (home, irrigation, municipal, industrial)

- WELL COMPLETION DATA:
- (1) diameter (inches) 16"
 - (2) total depth (feet) 113'
 - (3) static water level (feet) 12' below top of ground.
 - (4) casing Steel 73'
(material) (depth)
16" if telescope see back.
(size)
 - (5) screen 40' 73'
(length) (depth to top)
1 1/2" Steel
(size) (material)
 - (6) pump 60 3000
(HP) (yield gpm)
DIESEL
(type power)
 - (7) electric log No
(yes or no)

(organization running log)
 (8) how well bottom plugged Plate

DRILLERS REMARKS:

description of formations encountered	from	to
Clay	0	31
FINE SAND CODED	32	62
SAND + GRAVEL	63	113
Bottom 113'		


Miss. Board of Water Comm.

FEB 6 1979

RECEIVED

If well telescopes please sketch and show depths.

GROUND LEVEL

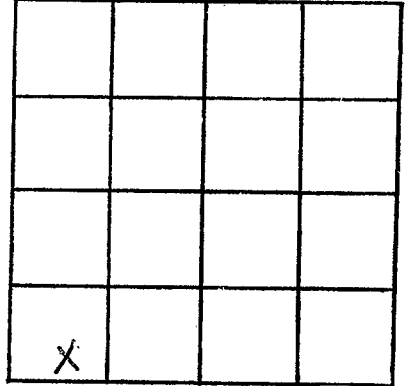

SECTION 36

Please indicate well location X.

ADDITIONAL INFORMATION

If more than one screen,
show locations of each on sketch.