

SUNFLOWER
S 23
6/20/79

MISSISSIPPI
BOARD OF WATER COMMISSIONERS
416 North State Street
Jackson, Mississippi 39201

CODED

WATER WELL DRILLERS LOG

6/20 1979
date well completed

DYER WELL + IRR
firm name

SUNFLOWER
county well located

LANDOWNER:	description of formations encountered	from	to
HOLLY RIDGE PLTG CO	CLAY	0	20
HOLLY RIDGE (mailing address)	FINE SAND	20	28
WELL LOCATION:	SAND	28	45
sec. <u>1</u> T. <u>17</u> N. R. <u>5</u> E	SAND & GRAVEL	45	110
<u>4</u> miles WEST of INVERNESS (distance) (direction) (nearest town)			
WELL PURPOSE: (home, irrigation, municipal, industrial)			
WELL COMPLETION DATA:			
(1) diameter (inches) <u>16</u>			
(2) total depth (feet) <u>110</u>			
(3) static water level (feet) <u>18</u> ^{below} _{above} top of ground.			
(4) casing <u>STEEL</u> , <u>70</u> (material) (depth)			
<u>16</u> if telescope see back. (size)			
(5) screen <u>40'</u> , <u>70</u> (length) (depth to top)			
<u>16</u> , <u>STEEL</u> (size) (material)			
(6) pump <u>40</u> <u>1800-2000</u> (HP) (yield gpm)			
<u>DIESEL</u> (type power)			
(7) electric log <u>NO</u> (yes or no)			
(organization running log)			
(8) how well bottom plugged <u>PLATE</u>			
DRILLERS REMARKS:			

CODED


DEPT. OF NATURAL RESOURCES
BUREAU OF LAND & WATER RESOURCES

OCT 29 1979

RECEIVED

If well telescopes please sketch and show depths.

GROUND LEVEL

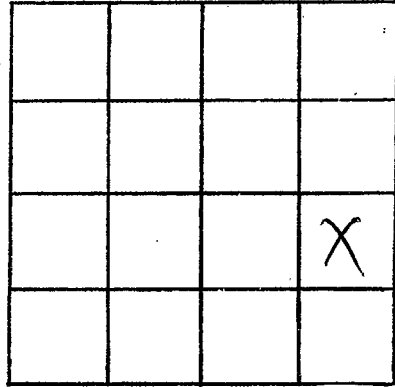

SECTION 1

Please indicate well location X.

ADDITIONAL INFORMATION

If more than one screen, show locations of each on sketch.