

MISSISSIPPI DEPARTMENT OF NATURAL RESOURCES

Bureau of Land and Water Resources

Southport Mall

P.O. Box 10631

Jackson, Mississippi 39209

WATER WELL DRILLERS LOG

CODED

Sunflower
S 28
8-4-80

Sunflower

08/04/80 19 Larry's Well & Pump Humphrey
 date well completed firm name county well located

LANDOWNER: Paul Moon
Isola, MS.
 (mailing address)

description of formations encountered	from	to
<i>clay</i>	0	20
<i>fine sand</i>	20	25
<i>med sand</i>	25	50
<i>coarse sand & gravel</i>	50	103

WELL LOCATION:
 sec 33 T 17 N R 5 E
9 miles West of Isola
 (distance) (direction) (nearest town)

WELL PURPOSE: Fish Pond
 (home, irrigation, municipal, industrial)

WELL COMPLETION DATA:

(1) diameter (inches) 16"

(2) total depth (feet) 103'

(3) static water level (feet) 18 below above top of ground.

(4) casing Steel 63'
 (material) (depth)

 if telescope see back.
 (size)

(5) screen 40' 63'
 (length) (depth to top)

16" steel
 (size) (material)

(6) pump 60 3000
 (HP) (yield gpm)

0
 (type power)

(7) electric log No
 (yes or no)

 (organization running log)

(8) how well bottom plugged Steel Plate

CODED

DEPT. OF NATURAL RESOURCES
 BUREAU OF LAND & WATER RESOURCES


APR 28 1981

RECEIVED

DRILLERS REMARKS:

If well telescopes please
sketch and show depths.

GROUND LEVEL

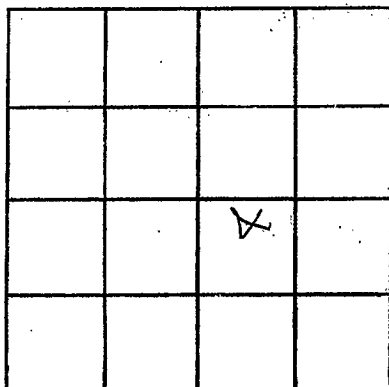

SECTION SB

Please indicate well location X.

ADDITIONAL INFORMATION

If more than one screen,
show locations of each on sketch.