

MISSISSIPPI DEPARTMENT OF NATURAL RESOURCES

Bureau of Land and Water Resources

Southport Mall

P.O. Box 10631

Jackson, Mississippi 39209

WATER WELL DRILLERS' LOG

CODED

SUNFLOWER
S 30
7-21-81

7/21/81
date well completed

Open Well & Surg
firm name

Sunflower
county well located

LANDOWNER: Bruce Bramford

description of formations encountered

from

to

Business, MS
(mailing address)

WELL LOCATION:

sec. 1 T 17 N R 5 E
5 miles W of Business
(distance) (direction) (nearest town)

WELL PURPOSE:

(home, irrigation, municipal, industrial)

WELL COMPLETION DATA:

- (1) diameter (inches) 16
- (2) total depth (feet) 103'
- (3) static water level (feet) 21 below top of ground.
- (4) casing Steel 63'
(material) (depth)
16 If telescope see back.
(size)
- (5) screen 401 63'
(length) (depth to top)
16 Steel
(size) (material)
- (6) pump 460 3000
(HP) (yield gpm)
Diesel
(type power)
- (7) electric log NO
(yes or no)

(organization running log)


(8) how well bottom plugged Plate

DRILLERS REMARKS:

3955


san	13	23
san	23	33
san	33	43
san & sand	43	53
gravel	53	63
san & gravel	63	73
gravel	73	83
gravel	83	93
gravel & baffle	93	103
↓ clay		

CODED

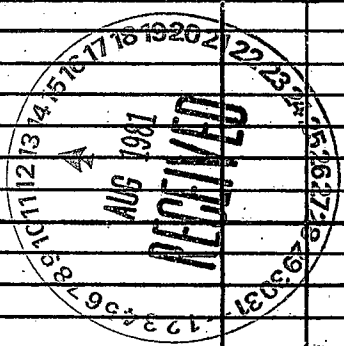

If well telescopes please sketch and show depths.

GROUND LEVEL

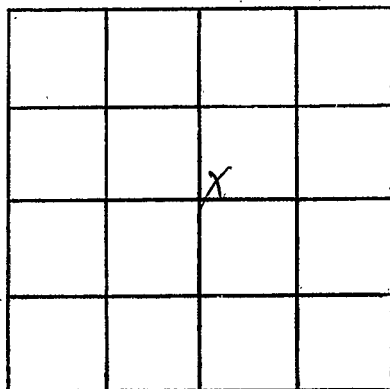

SECTION _____

Please indicate well location X.

ADDITIONAL INFORMATION

If more than one screen, show locations of each on sketch.