

MISSISSIPPI DEPARTMENT OF NATURAL RESOURCES

Bureau of Land and Water Resources

Southport Mall

P.O. Box 10631

Jackson, Mississippi 39209

WATER WELL DRILLERS LOG

CODED

SUNFLOWER
9 31
9-1-81

9-1
date well completed

1981 Dyer Well + Irr.
firm name

Sunflower
county well located

LANDOWNER: Paul Mood

description of formations encountered	from	to
Clay	0	48
fine sand	48	85
Sand + Gravel	85	110

Isola, Miss.
(mailing address)

WELL LOCATION:
sec 25 T 17 N S R 5 E W
4 miles West of Isola
(distance) (direction) (nearest town)

WELL PURPOSE: irrigation
(home, irrigation, municipal, industrial)

WELL COMPLETION DATA:

- (1) diameter (inches) 16"
- (2) total depth (feet) 110'
- (3) static water level (feet) 22' below top of ground.
- (4) casing Steel, 70'
(material) (depth)
16" If telescope see back.
(size)
- (5) screen 40', 70'
(length) (depth to top)
16", Mild Steel
(size) (material)
- (6) pump 600, 2800-3000
(HP) (yield gpm)
DIESEL
(type power)
- (7) electric log No
(yes or no)
None
(organization running log)
- (8) how well bottom plugged Plate

DRILLERS REMARKS:


DEPT. OF NATURAL RESOURCES
BUREAU OF LAND & WATER RESOURCES

SEP 16 1981

RECEIVED

If well telescopes please sketch and show depths.

GROUND LEVEL

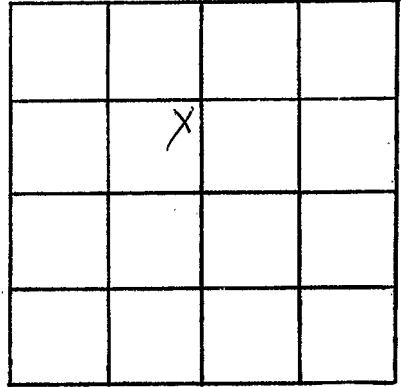

SECTION 35

Please indicate well location X.

ADDITIONAL INFORMATION

If more than one screen, show locations of each on sketch.