

MISSISSIPPI DEPARTMENT OF NATURAL RESOURCES

Bureau of Land and Water Resources

Southport Mall

P.O. Box 10631

Jackson, Mississippi 39209

WATER WELL DRILLERS LOG

CODED

Sunflower
35
7-8-81

July 08
 date well completed

1981

Larry's well & Pump
 firm name

Sunflower
 county well located

LANDOWNER: Paul moon

description of formations encountered

from

to

Isola ms.
 (mailing address)

<u>Clay</u>	<u>0</u>	<u>30</u>
<u>fine sand</u>	<u>30</u>	<u>65</u>
<u>course sand</u>	<u>65</u>	<u>116</u>

WELL LOCATION:

sec. 35 T. 17 N. R. 5 W.
11 miles W of Isola
 (distance) (direction) (nearest town)

WELL PURPOSE: Fish Pond
 (home, irrigation, municipal, industrial)

WELL COMPLETION DATA:

- (1) diameter (inches) 16"
- (2) total depth (feet) 116'
- (3) static water level (feet) 20' ^{below}/_{above} top of ground.
- (4) casing Steel 76'
 (material) (depth)

 if telescope see back.
 (size)

- (5) screen 40' 76'
 (length) (depth to top)
16" Steel
 (size) (material)

- (6) pump 00 3000
 (HP) (yield gpm)
 (type power)

- (7) electric log No.
 (yes or no)

 (organization running log)

- (8) how well bottom plugged Steel Plate

DRILLERS REMARKS:

CODED


DEPT. OF NATURAL RESOURCES
 BUREAU OF LAND & WATER RESOURCES

OCT 19 1981

RECEIVED

If well telescopes please sketch and show depths.

GROUND LEVEL

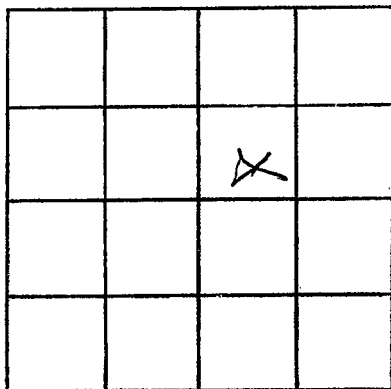

SECTION 35

Please indicate well location X.

ADDITIONAL INFORMATION

If more than one screen,
show locations of each on sketch.