

**MISSISSIPPI DEPARTMENT OF NATURAL RESOURCES**  
 Bureau of Land and Water Resources  
 Southport Mall  
 P.O. Box 10631  
 Jackson, Mississippi 39209  
**WATER WELL DRILLERS LOG**

**CODED**

**SUNFLOWER**  
 9 36  
 7-9-81

July 19 1981 Larry's Well & Pump Sunflower  
 date well completed firm name county well located

LANDOWNER: Paul Moon  
 Isola, MS.  
 (mailing address)  
 WELL LOCATION:  
 sec. 11 T. 17 N. R. 5 E  
 11 miles W of Isola  
 (distance) (direction) (nearest town)

| description of formations encountered | depth |     |
|---------------------------------------|-------|-----|
|                                       | from  | to  |
| Clay                                  | 60    | 35  |
| fine sand                             | 35    | 60  |
| Course + fine sand                    | 60    | 116 |

WELL PURPOSE: Fish Pond  
 (home, irrigation, municipal, industrial)

- WELL COMPLETION DATA:
- diameter (inches) 16"
  - total depth (feet) 116'
  - static water level (feet) 19' below top of ground.
  - casing Steel (material), 76' (depth)  
 (size) if telescope see back.
  - screen 40' (length), 76' (depth to top)  
16" (size), Steel (material)
  - pump 60 (HP), 3000 (yield gpm)  
 (type power)
  - electric log No (yes or no)  
 (organization running log)
  - how well bottom plugged Steel Plate

**CODED**

DEPT. OF NATURAL RESOURCES  
 BUREAU OF LAND & WATER RESOURCES


OCT 19 1981

**RECEIVED**

DRILLERS REMARKS:

If well telescopes please sketch and show depths.

GROUND LEVEL

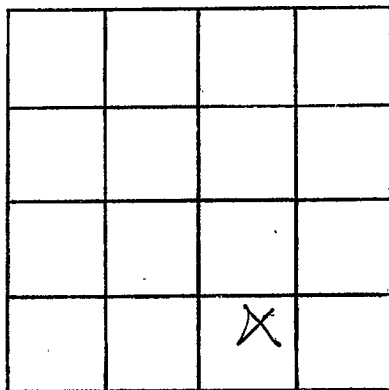

SECTION 35

Please indicate well location X.

ADDITIONAL INFORMATION

If more than one screen, show locations of each on sketch.