

MISSISSIPPI DEPARTMENT OF NATURAL RESOURCES

Bureau of Land and Water Resources

Southport Mall

P.O. Box 10631

Jackson, Mississippi 39209

WATER WELL DRILLERS LOG

CODED

SUNFLOWER
S 39
6-18-82

June 18 1982
 date well completed

South Delta
 firm name

Sunflower
 county well located

LANDOWNER:
Price
Inverness, MS
 (mailing address)

description of formations encountered	depth	
	from	to
<u>clay</u>	<u>0</u>	<u>10</u>
<u>fine sand</u>	<u>10</u>	<u>30</u>
<u>coarse sand</u>	<u>30</u>	<u>70</u>
<u>coarse sand w/ gravel</u>	<u>70</u>	<u>102</u>

WELL LOCATION:
 sec. 13 T. 170 N. R. 5 E. W. W
4 miles SW of Inverness
 (distance) (direction) (nearest town)

WELL PURPOSE:
 (home, irrigation, municipal, industrial)

- WELL COMPLETION DATA:
- (1) diameter (inches) 16"
 - (2) total depth (feet) 102'
 - (3) static water level (feet) 22' below above top of ground.
 - (4) casing steel 62'
 (material) (depth)
16" if telescope see back.
 (size)
 - (5) screen 40' 62'
 (length) (depth to top)
16" steel
 (size) (material)
 - (6) pump 40 1000
 (HP) (yield gpm)
Diesel
 (type power)
 - (7) electric log No
 (yes or no)

(organization running log)

(8) how well bottom plugged plate

DRILLERS REMARKS:


DEPT. OF NATURAL RESOURCES
 BUREAU OF LAND AND WATER RESOURCES

SEP 8 1982

RECEIVED

If well telescopes please sketch and show depths.

GROUND LEVEL

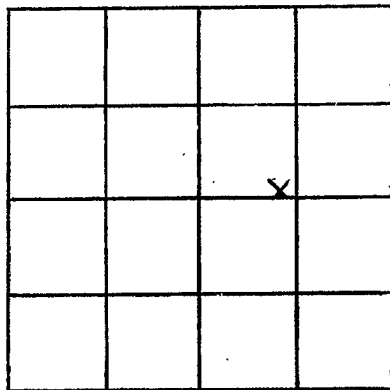

SECTION 13

Please indicate well location X.

ADDITIONAL INFORMATION

If more than one screen,
show locations of each on sketch.