

MISSISSIPPI DEPARTMENT OF NATURAL RESOURCES

Bureau of Land and Water Resources

Southport Mall

P.O. Box 10631

CODED

Jackson, Mississippi 39209

WATER WELL DRILLERS LOG

SUNFLOWER

S 40

6-14-82

June 14 1982 South Delta Sunflower
 date well completed firm name county well located

LANDOWNER:	description of formations encountered	from	to
Price Inverness, MS (mailing address)			
WELL LOCATION:	fine sand	20	50
sec. 13 T. 17 N. R. 5 E. S W	coarse sand	50	70
4 miles SW of Inverness (distance) (direction) (nearest town)	coarse sand & gravel	70	102
WELL PURPOSE: (home, irrigation, municipal, industrial)			
WELL COMPLETION DATA:			
(1) diameter (inches) 16"			
(2) total depth (feet) 102'			
(3) static water level (feet) 22' below top of ground.			
(4) casing Steel 62' (material) (depth) 16" if telescope see back. (size)			
(5) screen 40' 62' (length) (depth to top) 16" Steel (size) (material)			
(6) pump 40 1000 (HP) (yield gpm) Diesel (type power)			
(7) electric log NO (yes or no)			
(organization running log)			
(8) how well bottom plugged plate			

DEPT. OF NATURAL RESOURCES
 BUREAU OF LAND & WATER RESOURCES


SEP - 8 1982

DRILLERS REMARKS:

RECEIVED

If well telescopes please sketch and show depths.

GROUND LEVEL

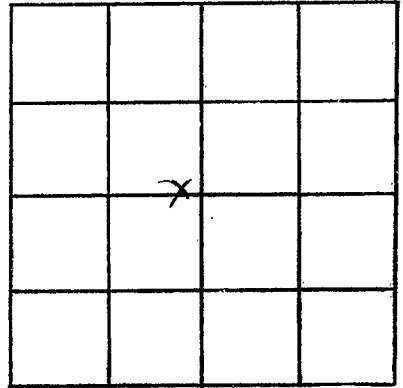

SECTION 13

Please indicate well location X.

ADDITIONAL INFORMATION

If more than one screen,
show locations of each on sketch.