

MISSISSIPPI DEPARTMENT OF NATURAL RESOURCES

Bureau of Land and Water Resources

Southport Mall

P.O. Box 10631

Jackson, Mississippi 39209

WATER WELL DRILLERS LOG

CODED

Sunflower

Lefflore

SAI
Sunflower
9-23-83

9-23
 date well completed

Larry's Pump + well serv.
 firm name

county well located

LANDOWNER:	description of formations encountered	from	to
<u>Bruce Broomfield</u>			
<u>Lefflore, Miss.</u>	<u>CLAY</u>	<u>0</u>	<u>34</u>
<u>Imverness (mailing address)</u>	<u>SAND GRAVEL</u>	<u>34</u>	<u>103</u>
WELL LOCATION:			
sec <u>3</u> T <u>17</u> N R <u>5</u> E			
<u>1</u> miles <u>N</u> of <u>Wildcat Bayou</u>			
(distance) (direction) (nearest town)			
WELL PURPOSE: (home, irrigation, municipal, industrial)			
WELL COMPLETION DATA:			
(1) diameter (inches) <u>10"</u>			
(2) total depth (feet) <u>103'</u>			
(3) static water level (feet) <u>20'</u> below above top of ground.			
(4) casing <u>PVC</u> , <u>63'</u> (material), (depth) (size) if telescope see back.			
(5) screen <u>40'</u> , <u>63'</u> (length), (depth to top)			
<u>10"</u> , <u>PVC</u> (size), (material)			
(6) pump <u>10</u> , <u>840/1500</u> (HP), (yield gpm)			
<u>electric</u> (type power)			
(7) electric log <u>no</u> (yes or no)			
(organization running log)			
(8) how well bottom plugged <u>cap</u>			
DRILLERS REMARKS:			

CODED


DEPT. OF NATURAL RESOURCES
 BUREAU OF LAND & WATER RESOURCES

OCT 3 1983

RECEIVED

If well telescopes please sketch and show depths.

GROUND LEVEL

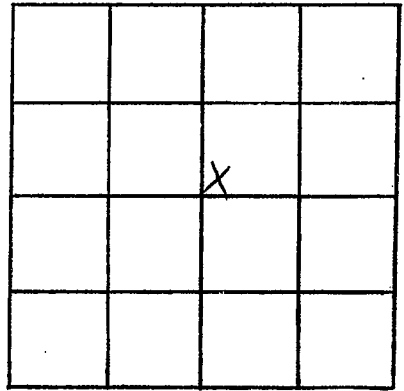

SECTION 3

Please indicate well location X.

ADDITIONAL INFORMATION

If more than one screen,
show locations of each on sketch.