

MISSISSIPPI DEPARTMENT OF NATURAL RESOURCES

Bureau of Land and Water Resources

Southport Mall

P.O. Box 10631

Jackson, Mississippi 39209

WATER WELL DRILLERS LOG

CODED

SCANTLOWERS
543
7/18/83

July 18, 1983 date well completed
Dyer Well + Irrigation firm name
Sunflower county well located

LANDOWNER: R-N. BARRETT
Indianola, Miss.
(mailing address)

WELL LOCATION:
sec. 8 T 17 N R 5 S
9 miles SW of Indianola
(distance) (direction) (nearest town)

WELL PURPOSE: Irrigation
(home, irrigation, municipal, industrial)


- WELL COMPLETION DATA:
- (1) diameter (inches) 16"
 - (2) total depth (feet) 108'
 - (3) static water level (feet) 22' below top of ground.
 - (4) casing Steel, 68' (material), (depth)
16 (size) if telescope see back.
 - (5) screen 40, 68' (length), (depth to top)
16, Mild Steel (size), (material)
 - (6) pump 60, 2000 (HP), (yield gpm)
Diesel (type power)
 - (7) electric log No (yes or no)
(organization running log)
 - (8) how well bottom plugged Plate

description of formations encountered	from	to
Clay	0	26
Fine sand	26	48
Sand	48	78
Sand + Gravel	78	108
CODED		
DEPT. OF NATURAL RESOURCES BUREAU OF LAND & WATER RESOURCES		
DEC - 7 1983		
RECEIVED		

DRILLERS REMARKS:

If well telescopes please sketch and show depths.

GROUND LEVEL

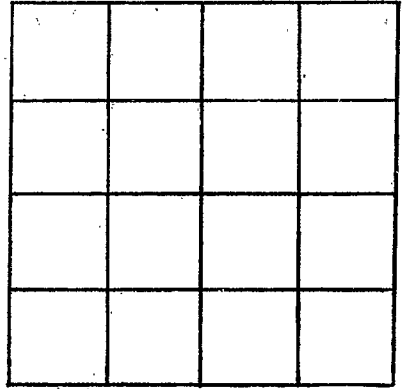

SECTION _____

Please indicate well location X.

ADDITIONAL INFORMATION

If more than one screen, show locations of each on sketch.